

**16**

**INSTRUCTIONAL BUILDING FOR PHYSICAL EDUCATION**  
 ST. CLOUD STATE COLLEGE ST. CLOUD, MINNESOTA

DEPARTMENT OF ADMINISTRATION  
 408N 120 STATE CAPITOL BUILDING ST. PAUL, MINNESOTA

APPROVED BY: PRESIDENT BY CLOUD STATE COLLEGE  
 STATE COLLEGE BOARD  
 COMMISSIONER OF ADMINISTRATION  
 AN AUTHORIZED SIGNATURE


A. J. NELSON, STATE ARCHITECT

**CROSS SECTIONS GYM**

TRAYNOR & HERMANSON ARCHITECTS ST. CLOUD  
 STRUCTURAL ENGINEERS JOHNSON & JENSEN MINNEAPOLIS, MINN.  
 CONSULTING ENGINEERS GAUEN & MOORE, INC. ST. PAUL, MINN.

DATE: 1-17-63  
 DRAWN: LLW: RAG  
 CHECKED: [Signature]

**15**  
 SHEET ARCHITECTURAL  
 OF 38  
 STATE PROJECT NUMBER  
 3425

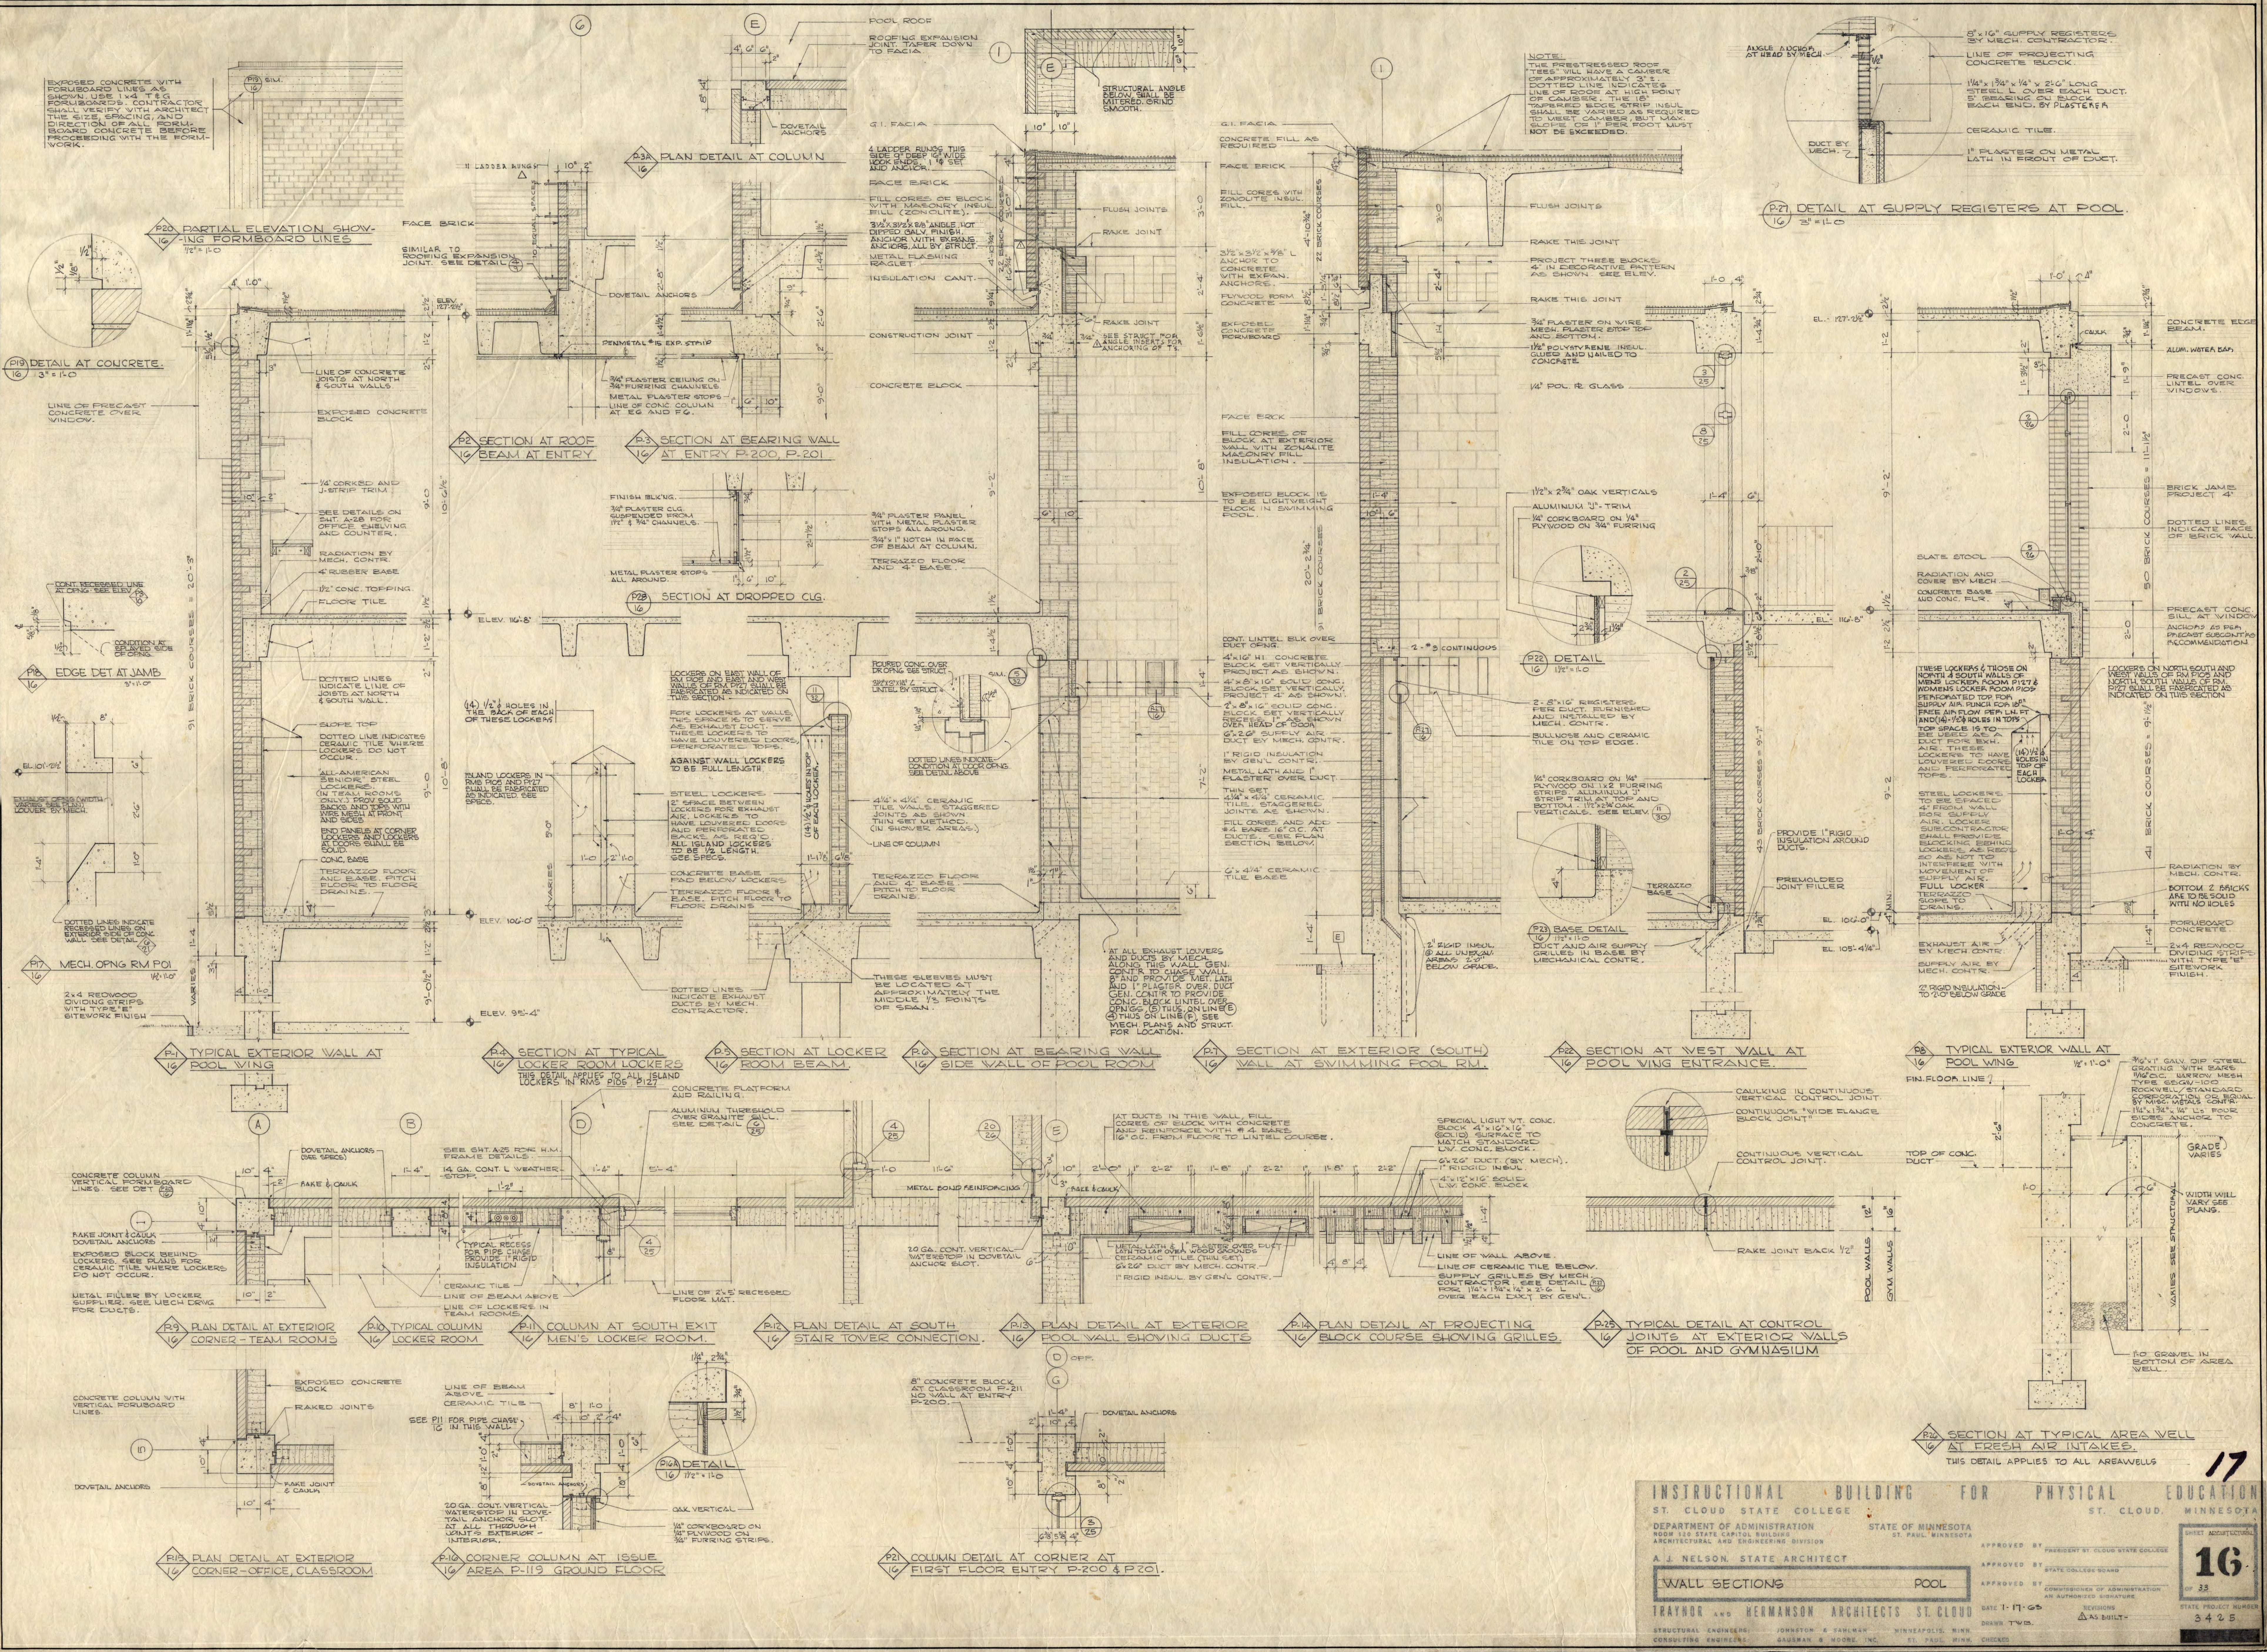

**INSTRUCTIONAL BUILDING FOR PHYSICAL EDUCATION**

ST. CLOUD STATE COLLEGE      ST. CLOUD, MINNESOTA

DEPARTMENT OF ADMINISTRATION      STATE OF MINNESOTA  
 ARCHITECTURAL AND ENGINEERING DIVISION      ST. PAUL, MINNESOTA
















A. J. NELSON, STATE ARCHITECT      APPROVED BY: PRESIDENT BY CLOUD STATE COLLEGE

**WALL SECTIONS**      **POOL**      APPROVED BY: STATE COLLEGE BOARD

TRAYNOR AND HERMANSON ARCHITECTS ST. CLOUD      APPROVED BY: ADMINISTRATOR OF ADMINISTRATION

DATE: 1-17-65      REVISIONS: AS BUILT      STATE PROJECT NUMBER: 3425

STRUCTURAL ENGINEERS: JOHNSTON & FARWELL      NINETEENTH, MINN.      CIVIL ENGINEERS: GARDNER & BROWN, INC.      ST. PAUL, MINN.      CONSULTANTS: CHICAGO

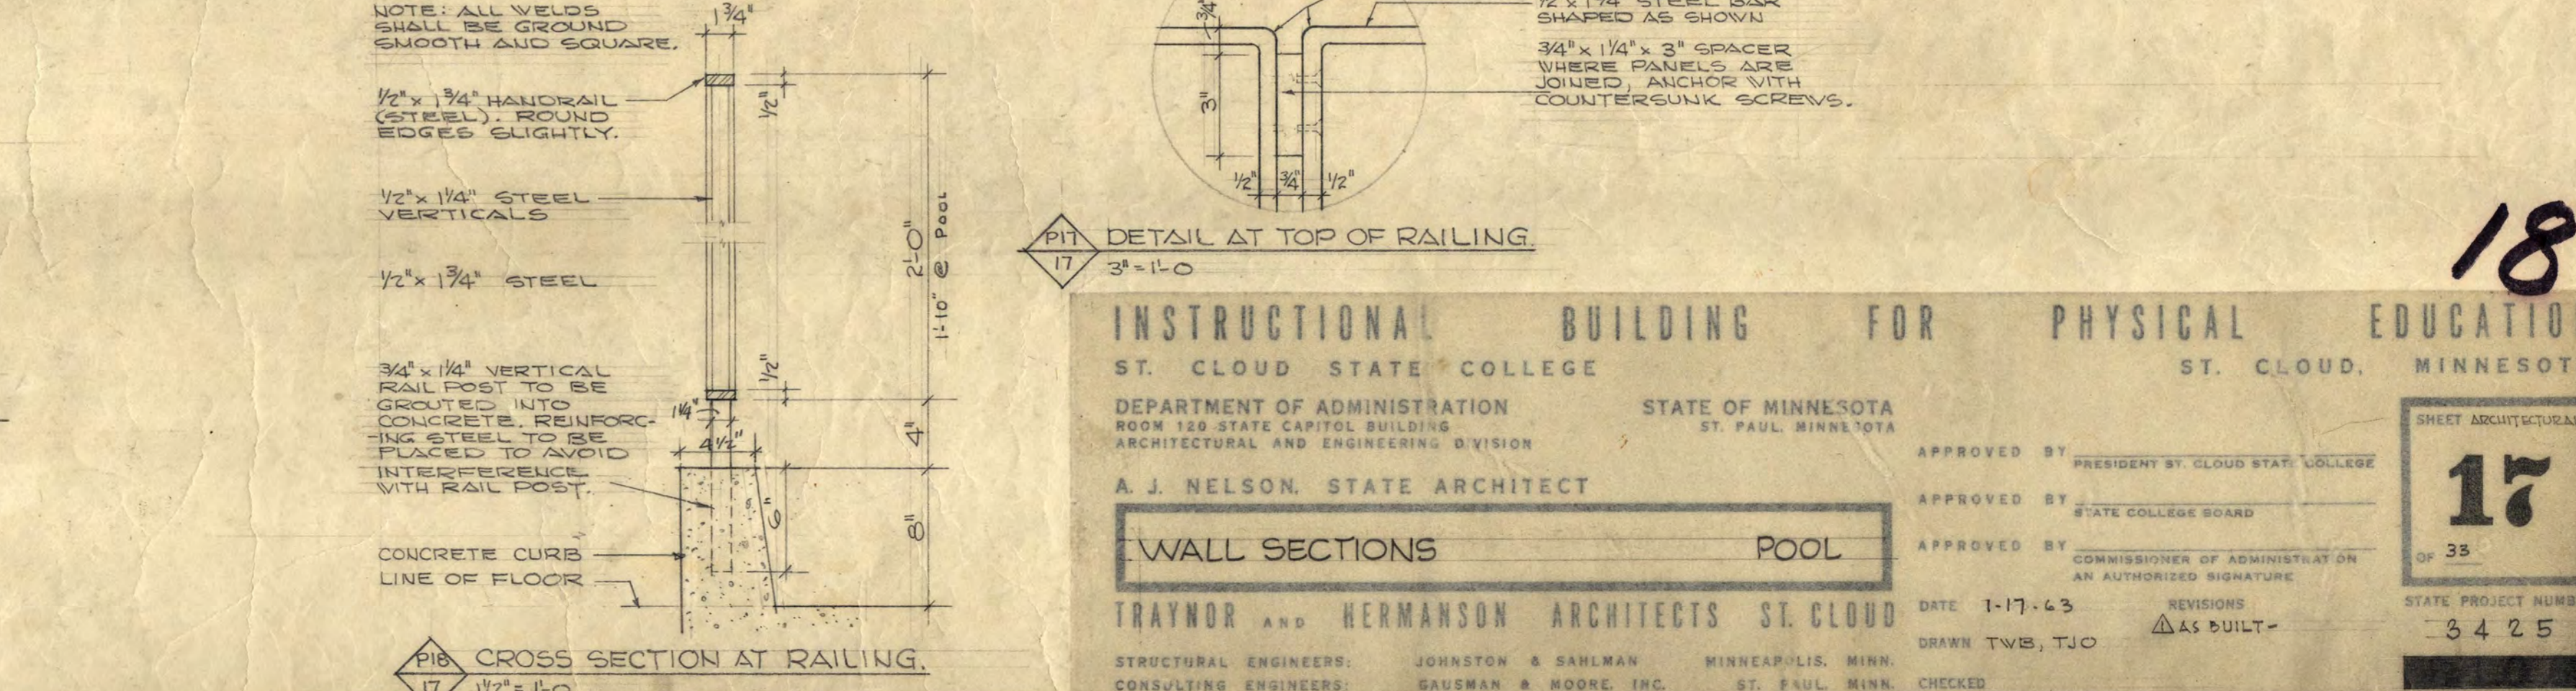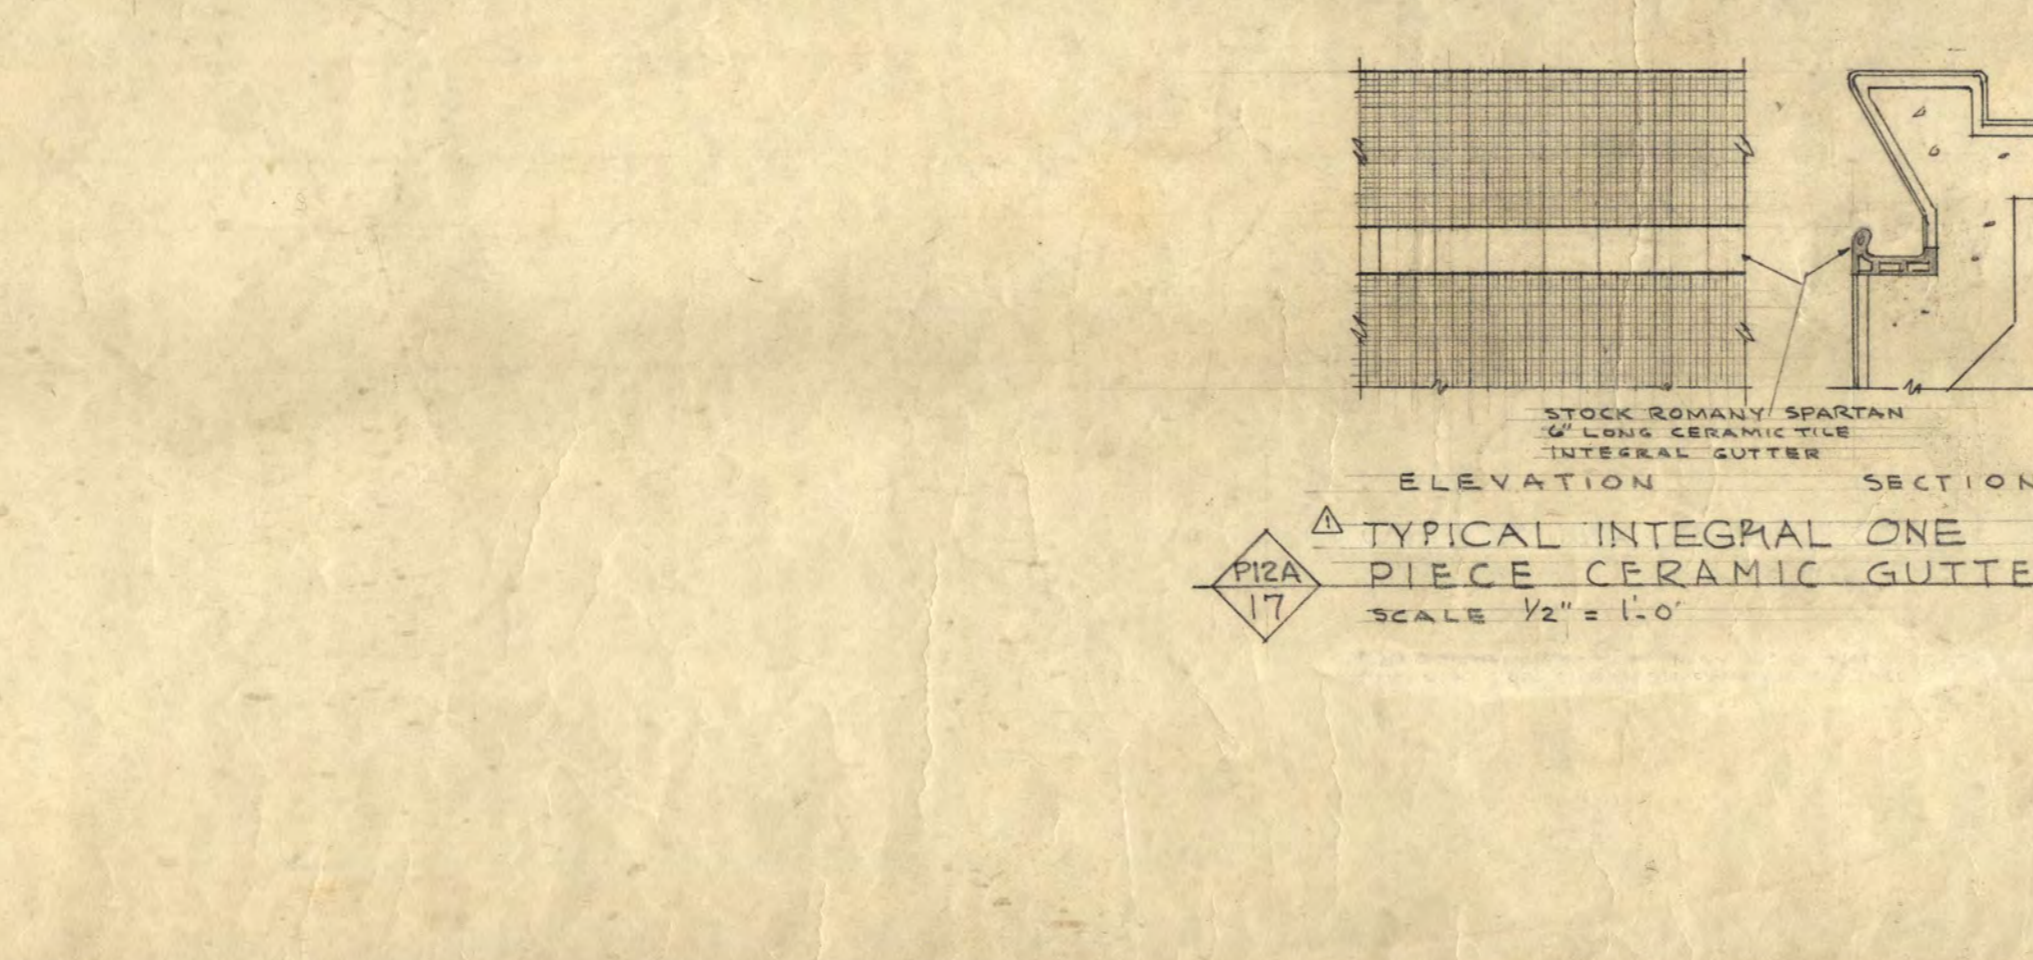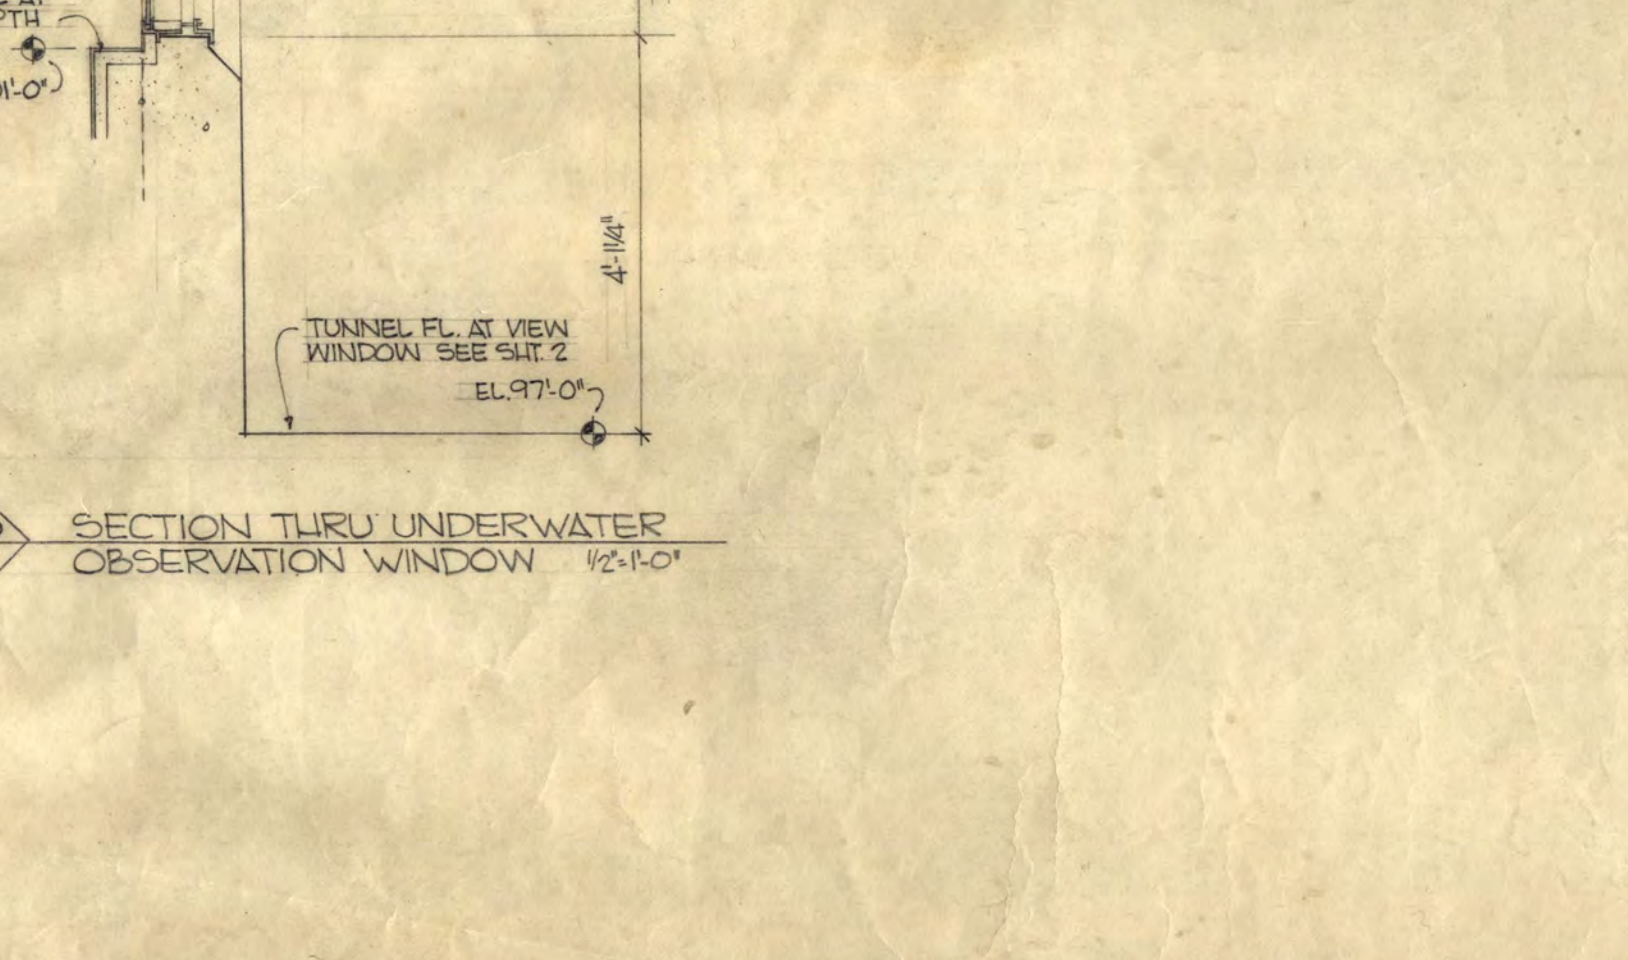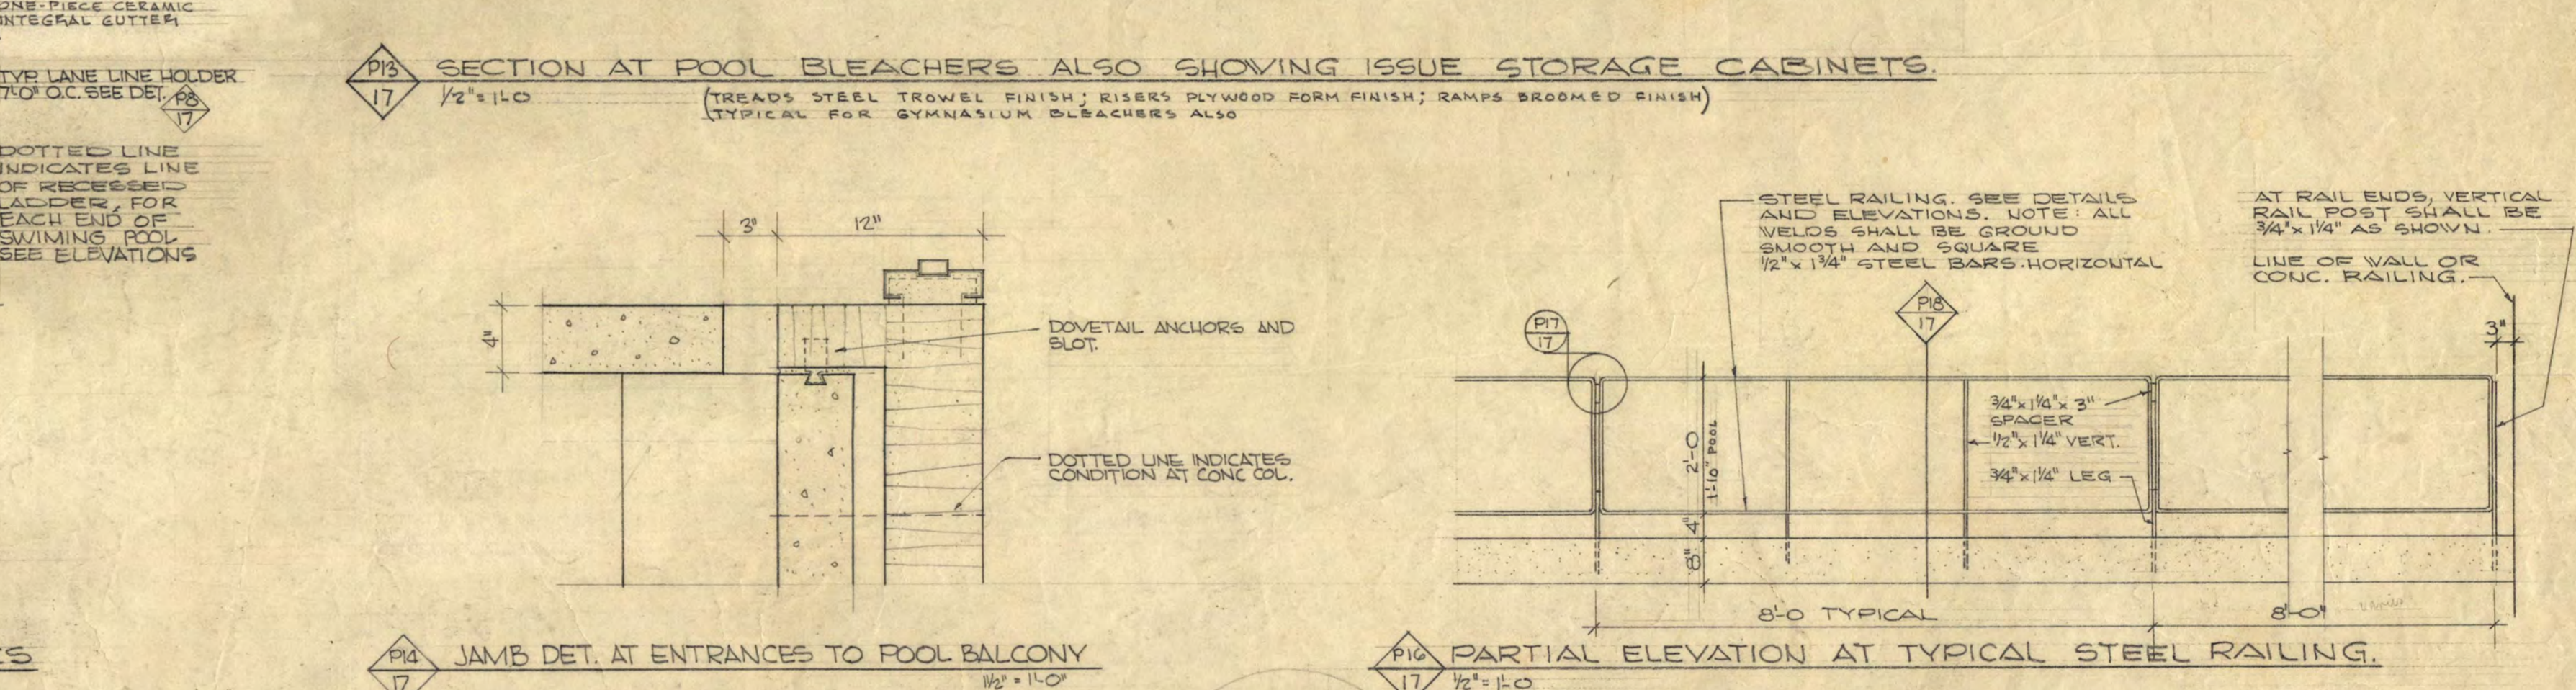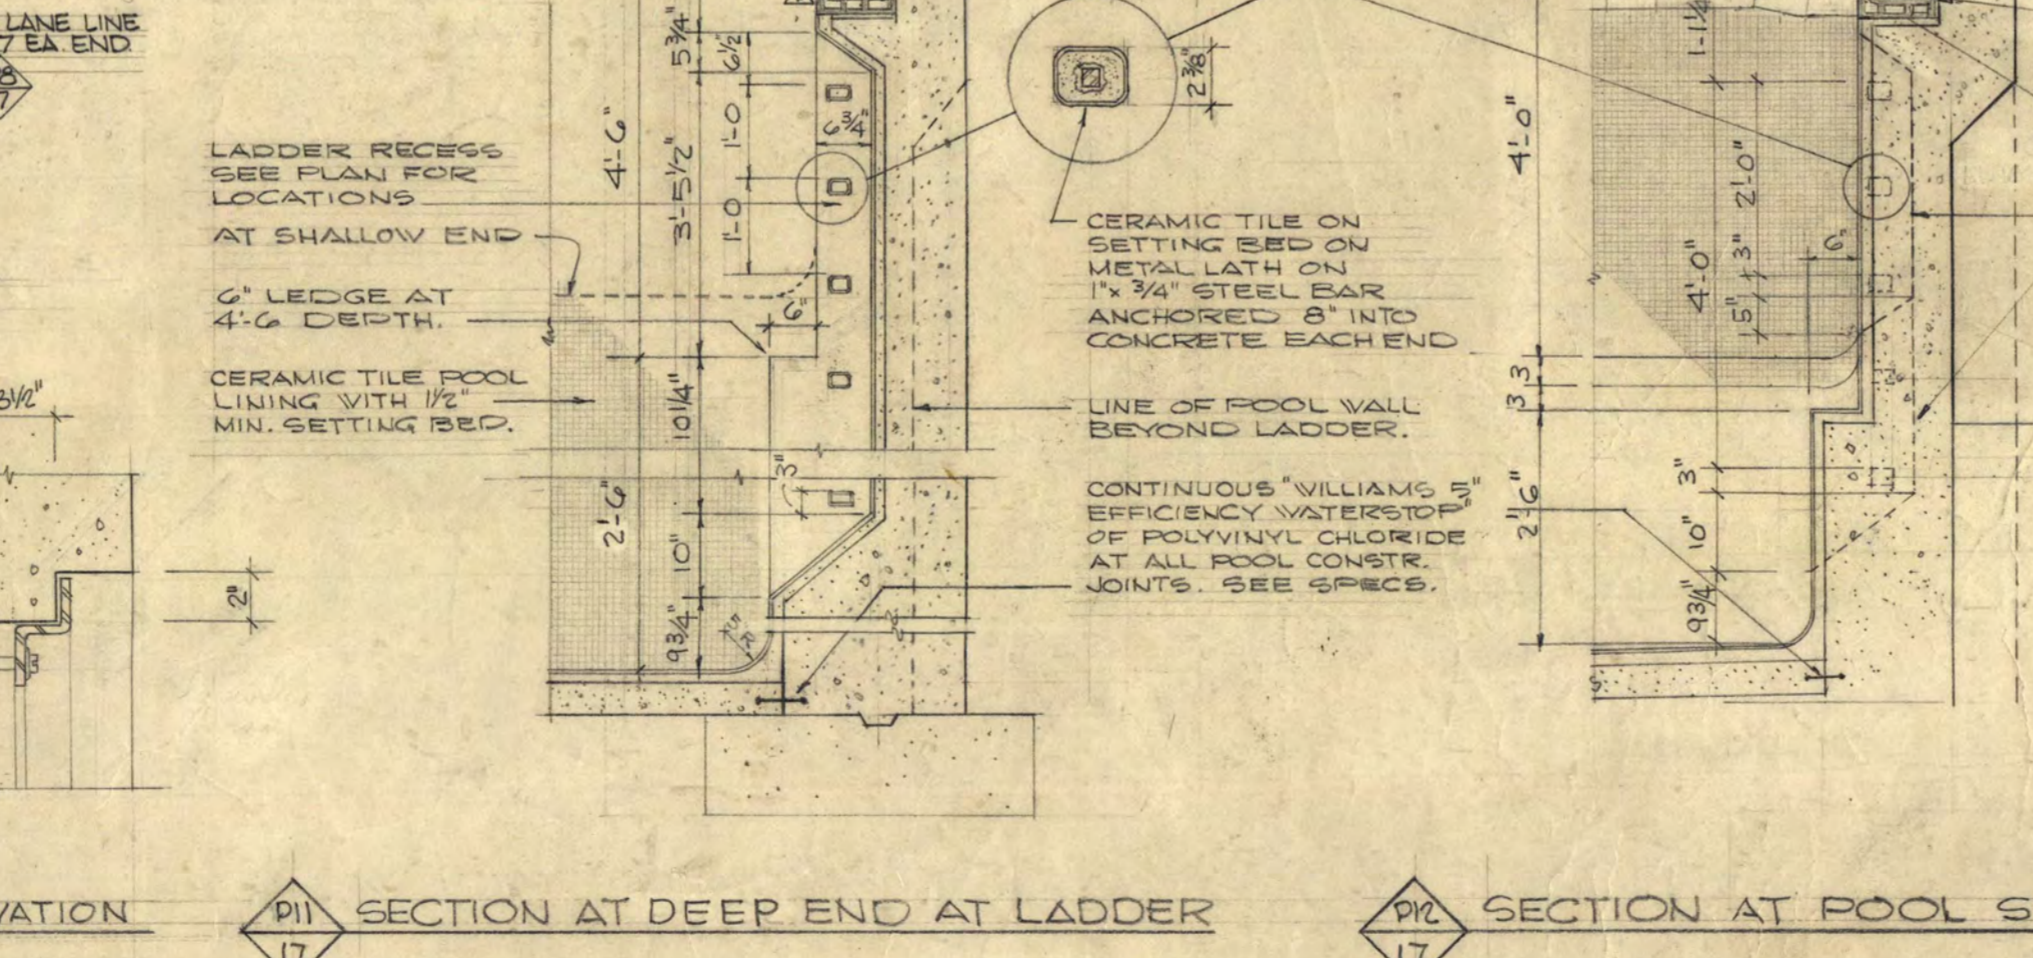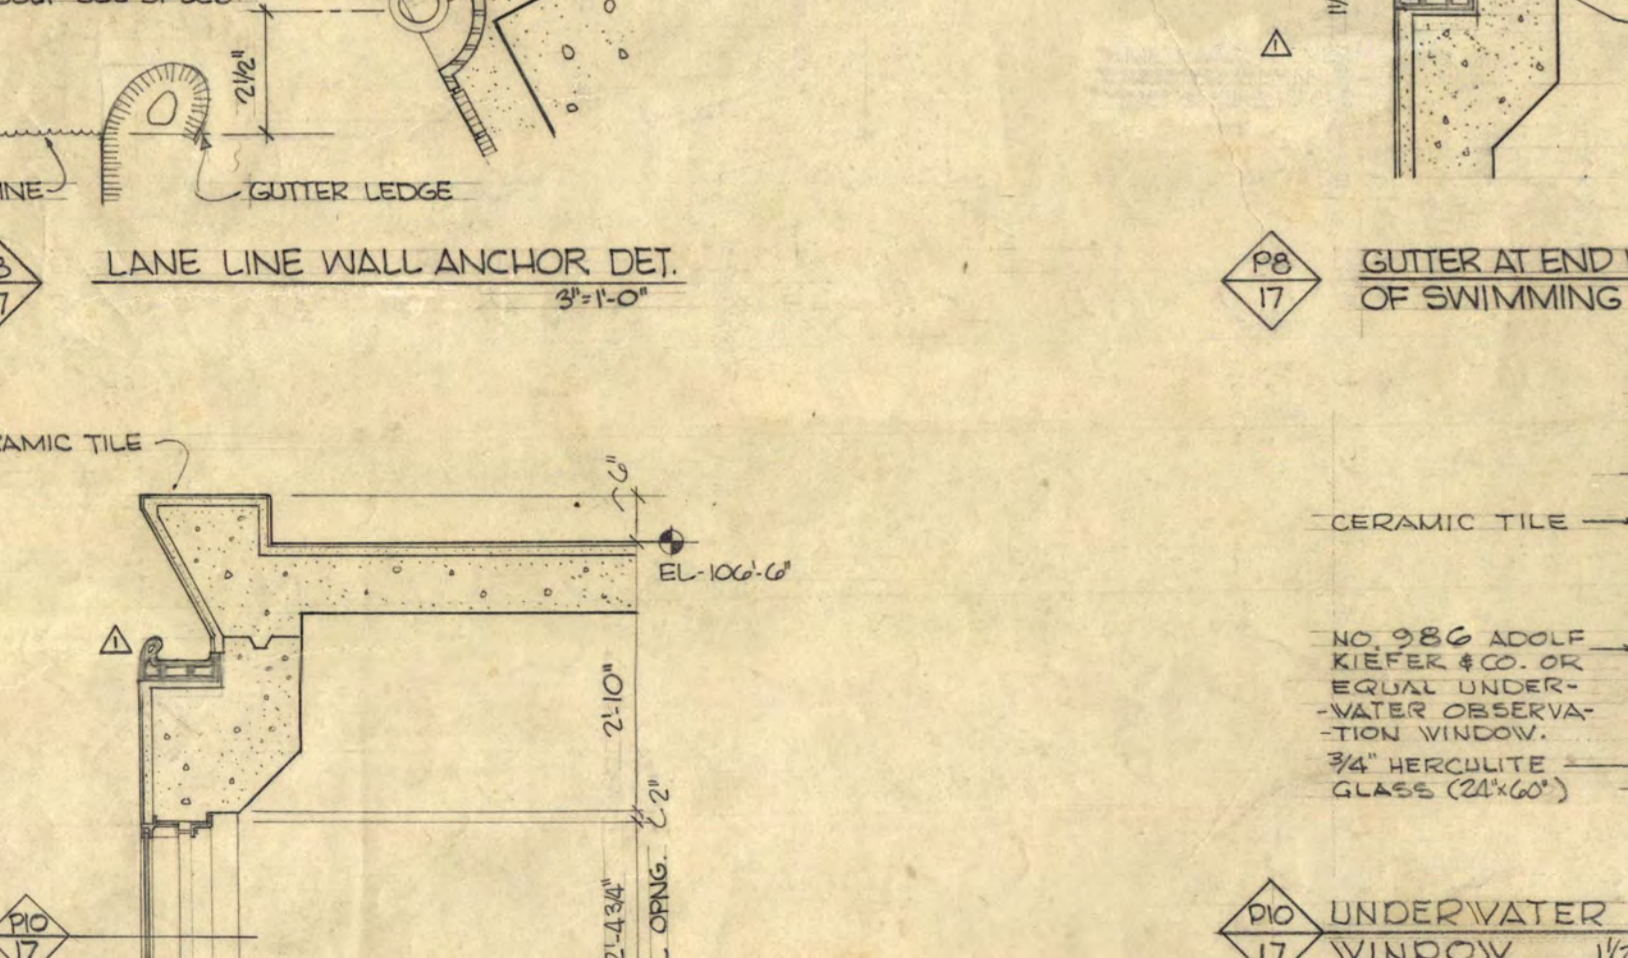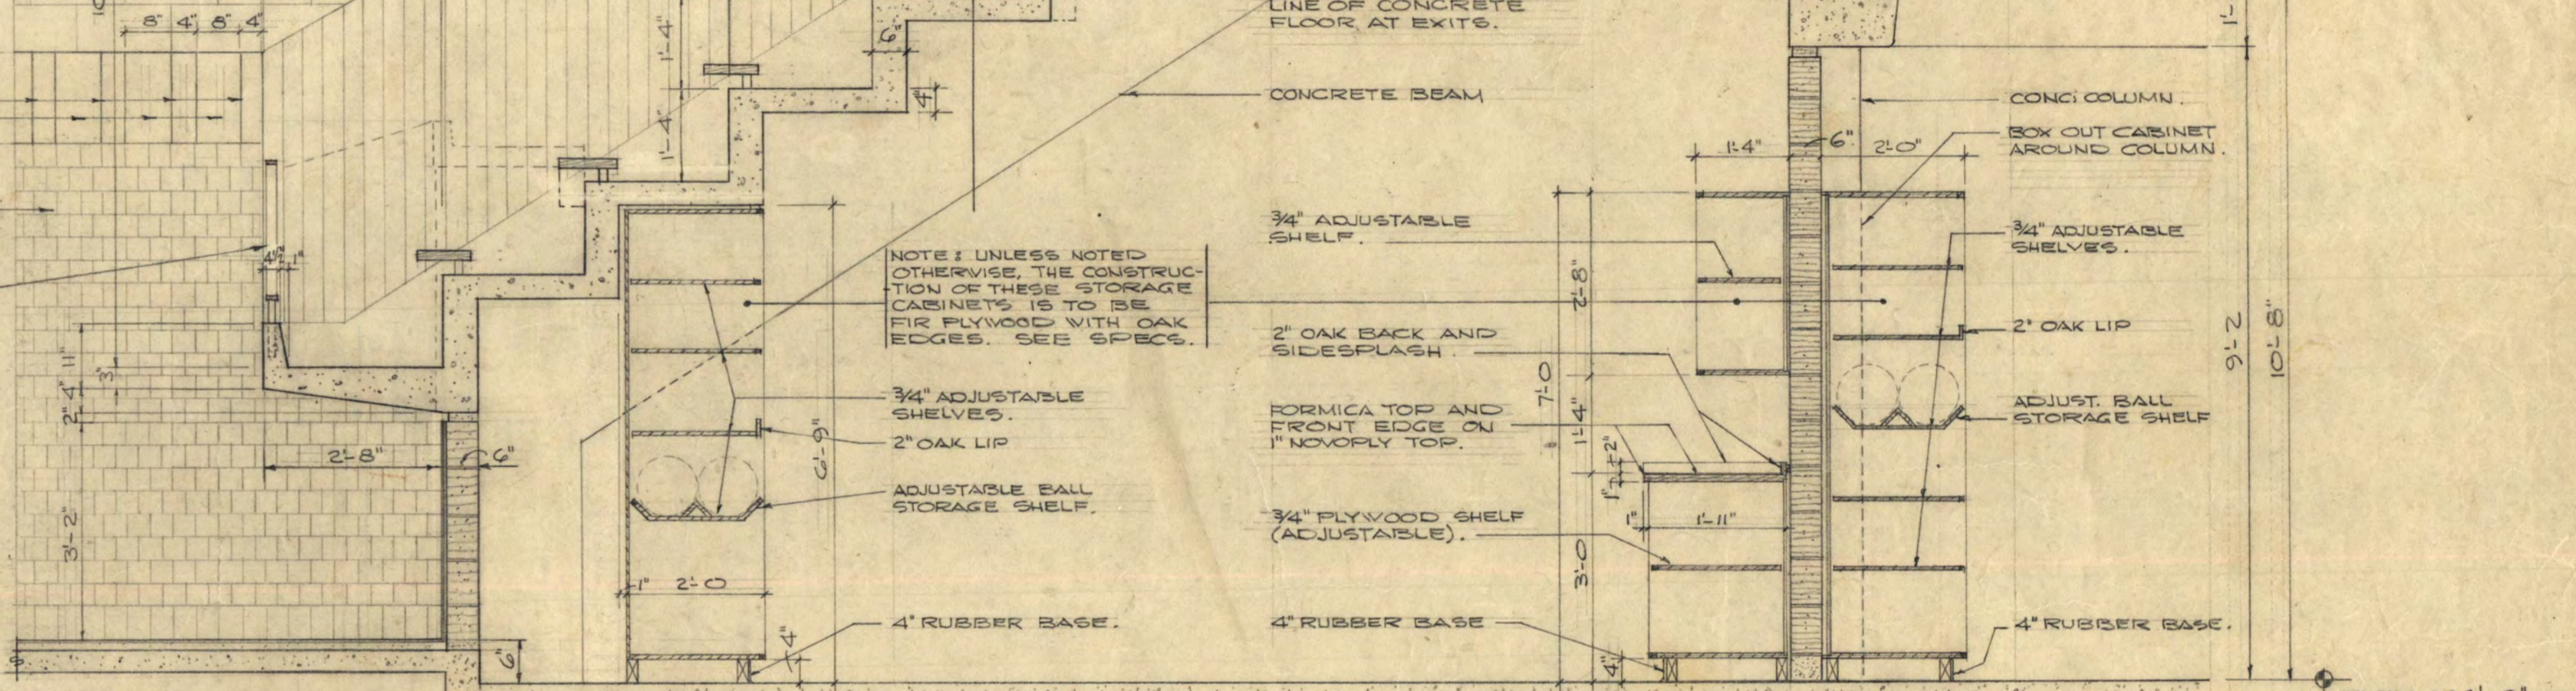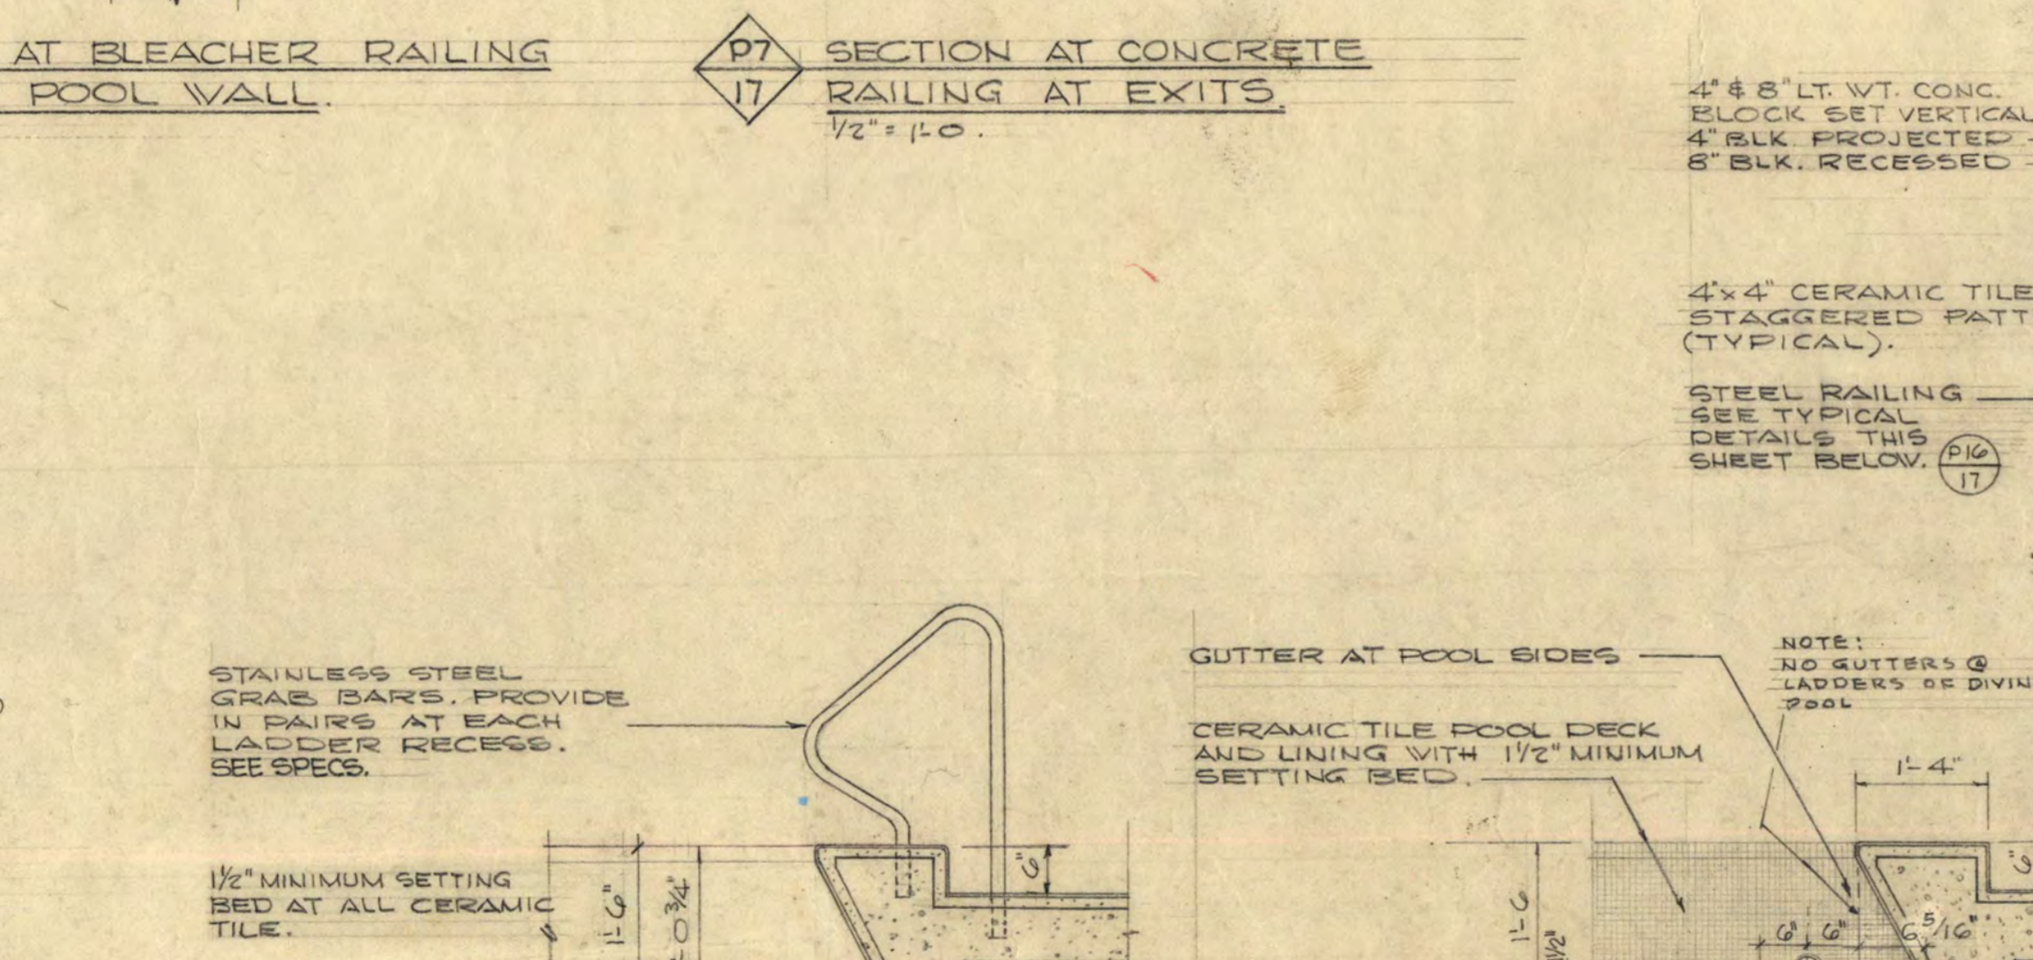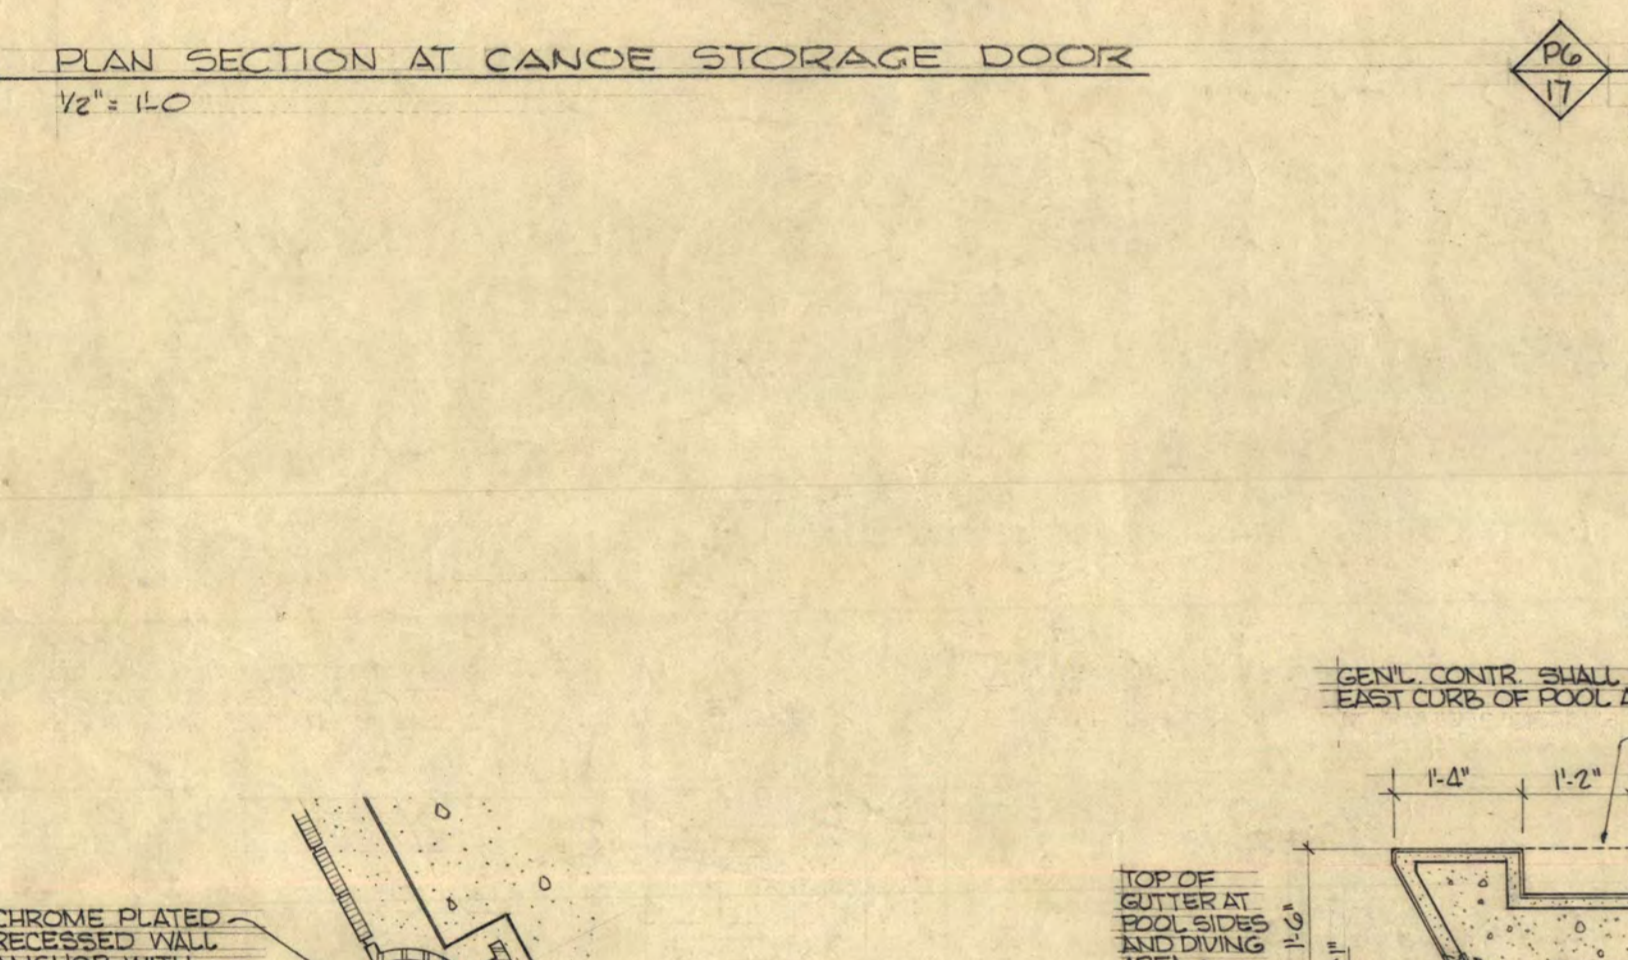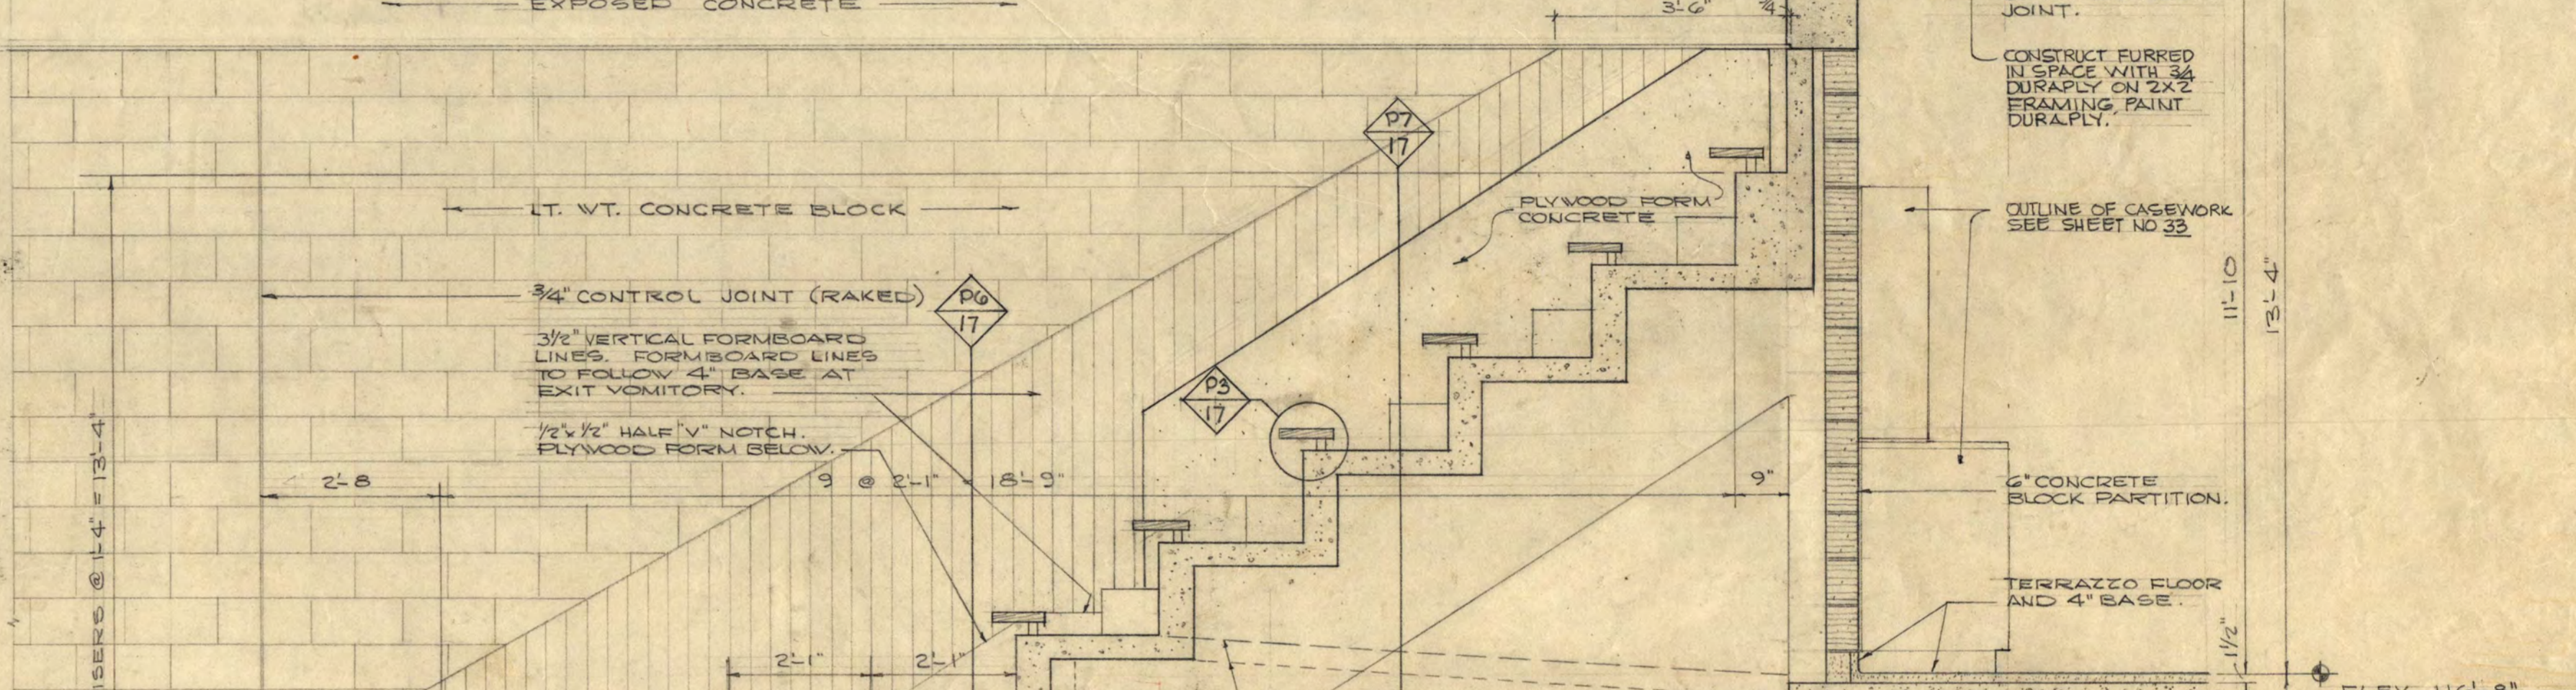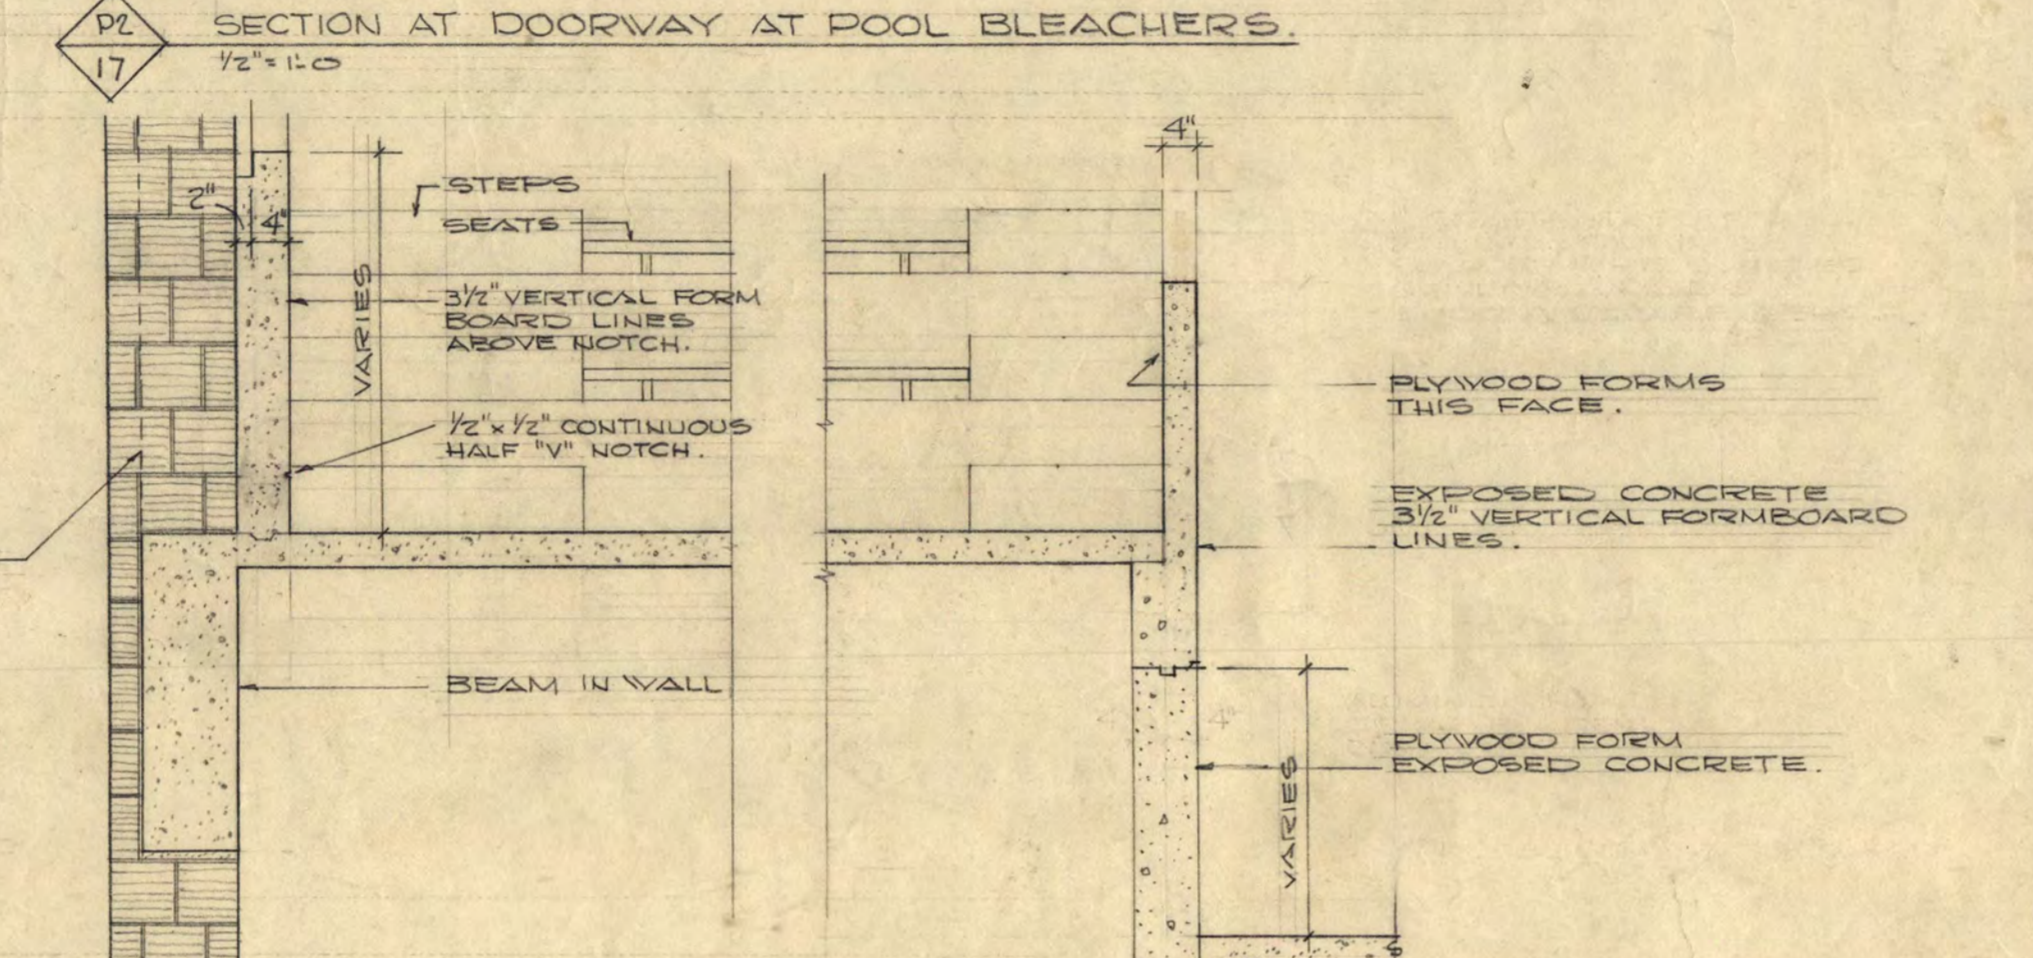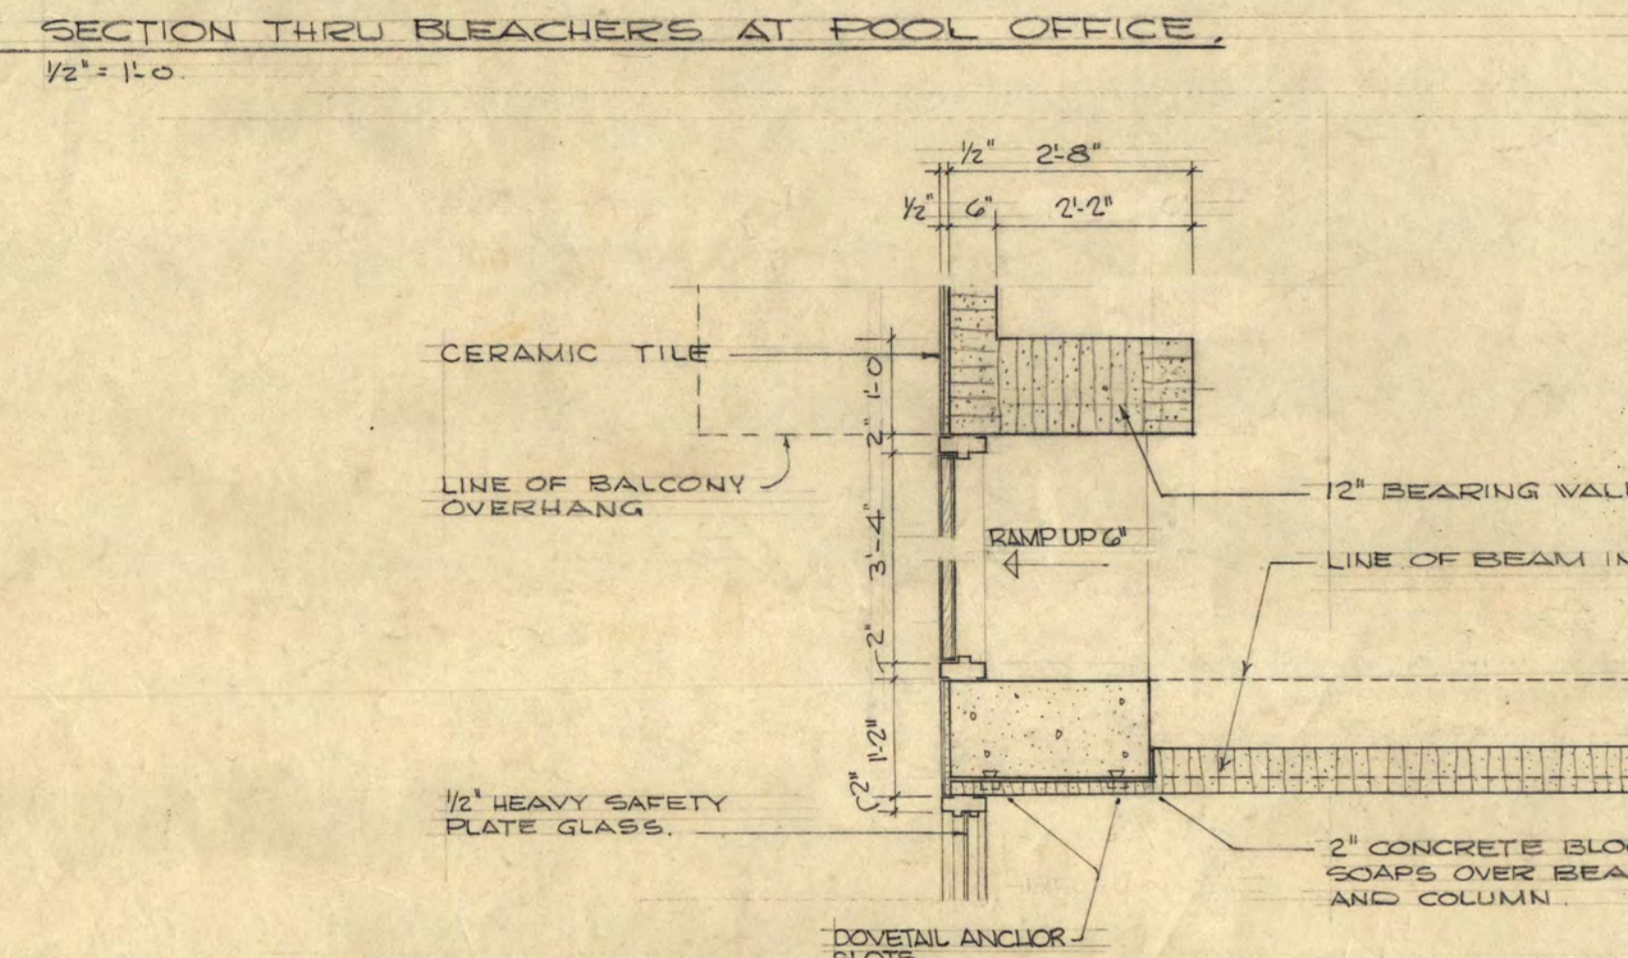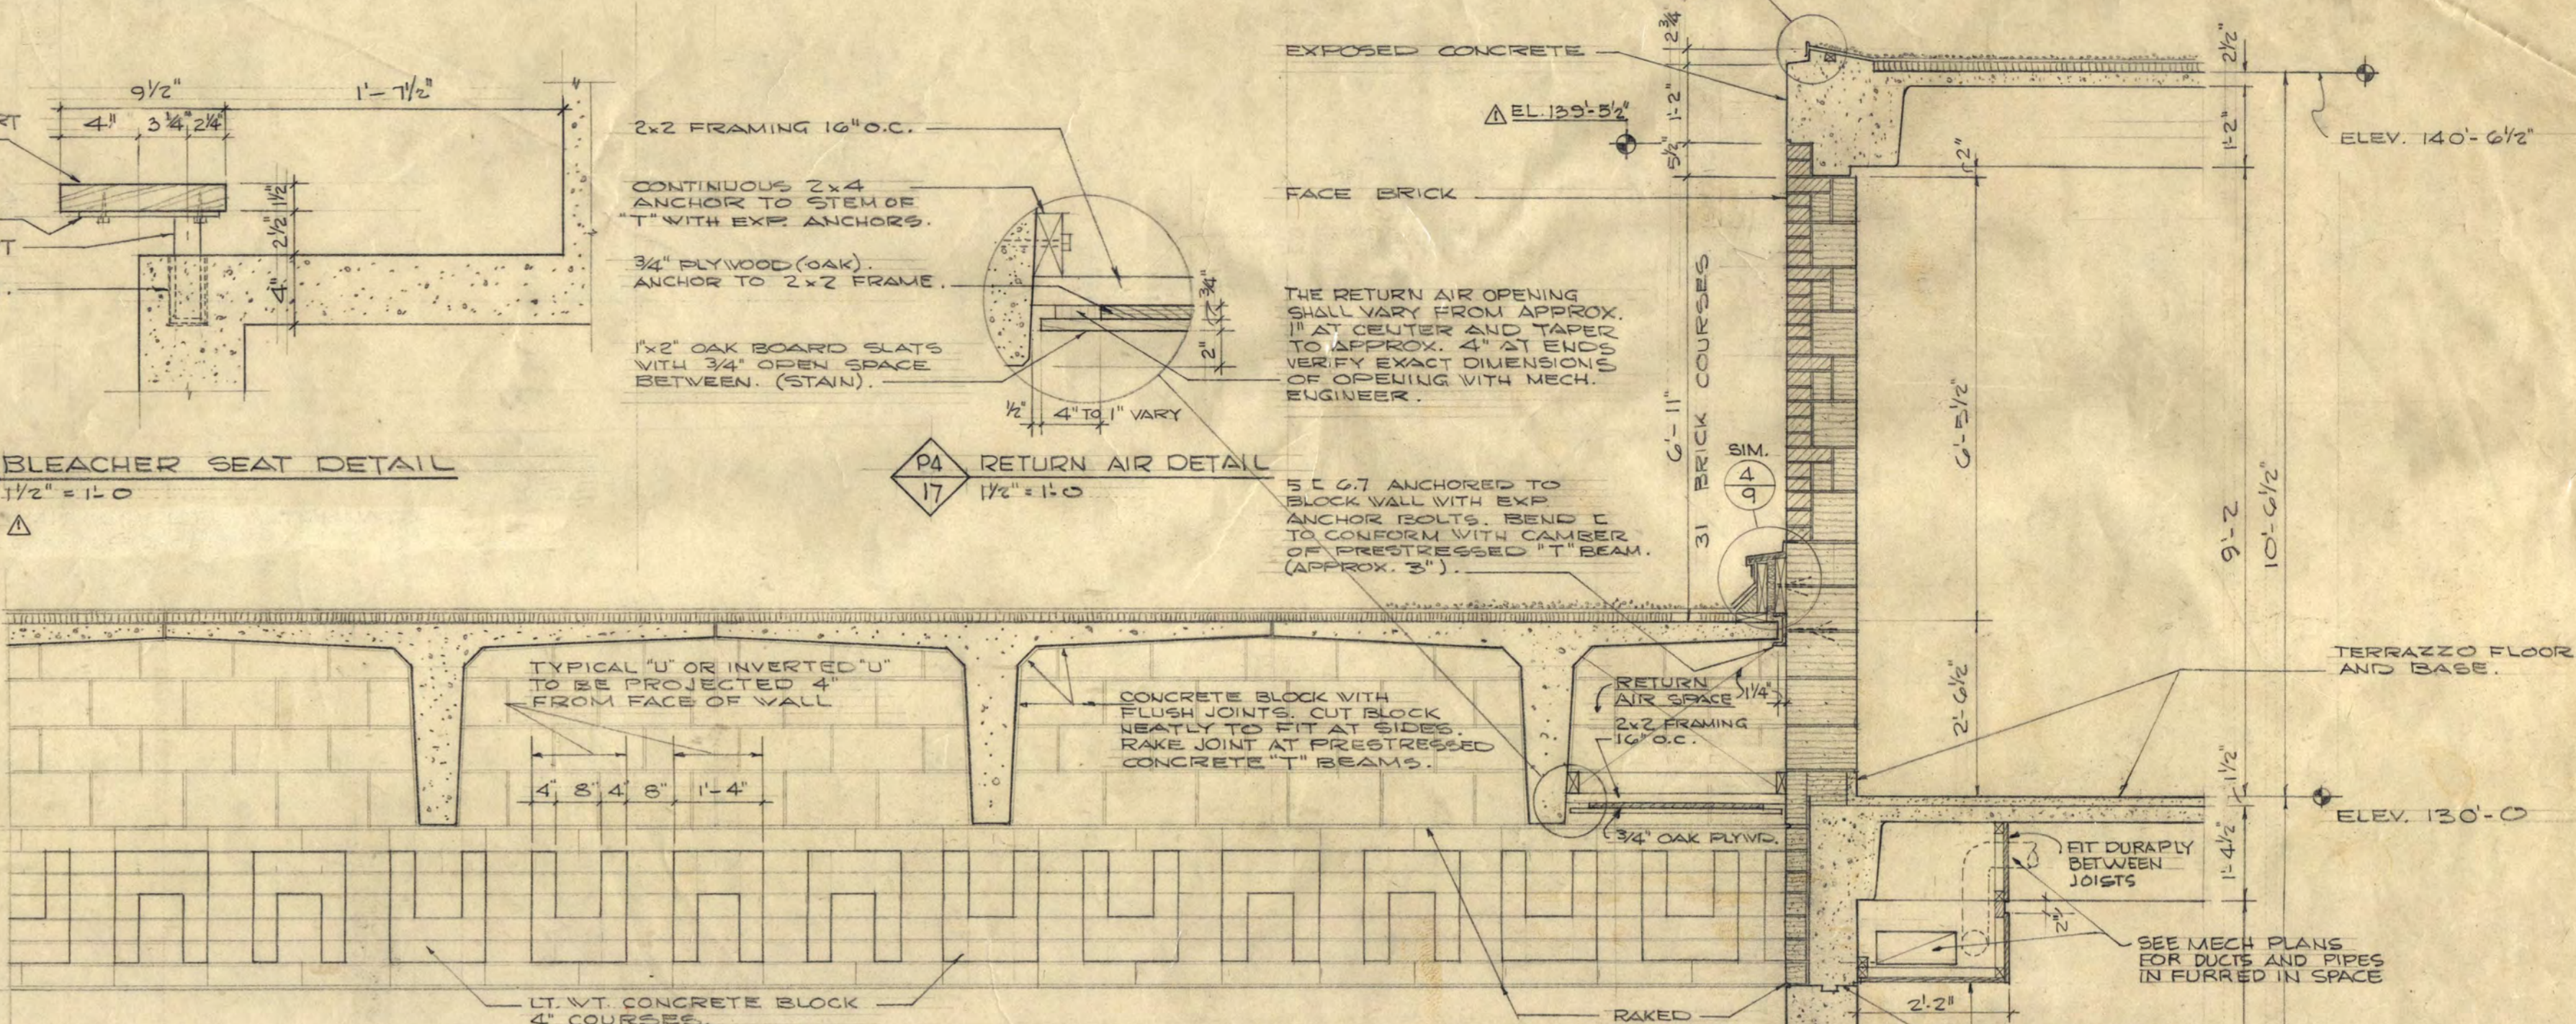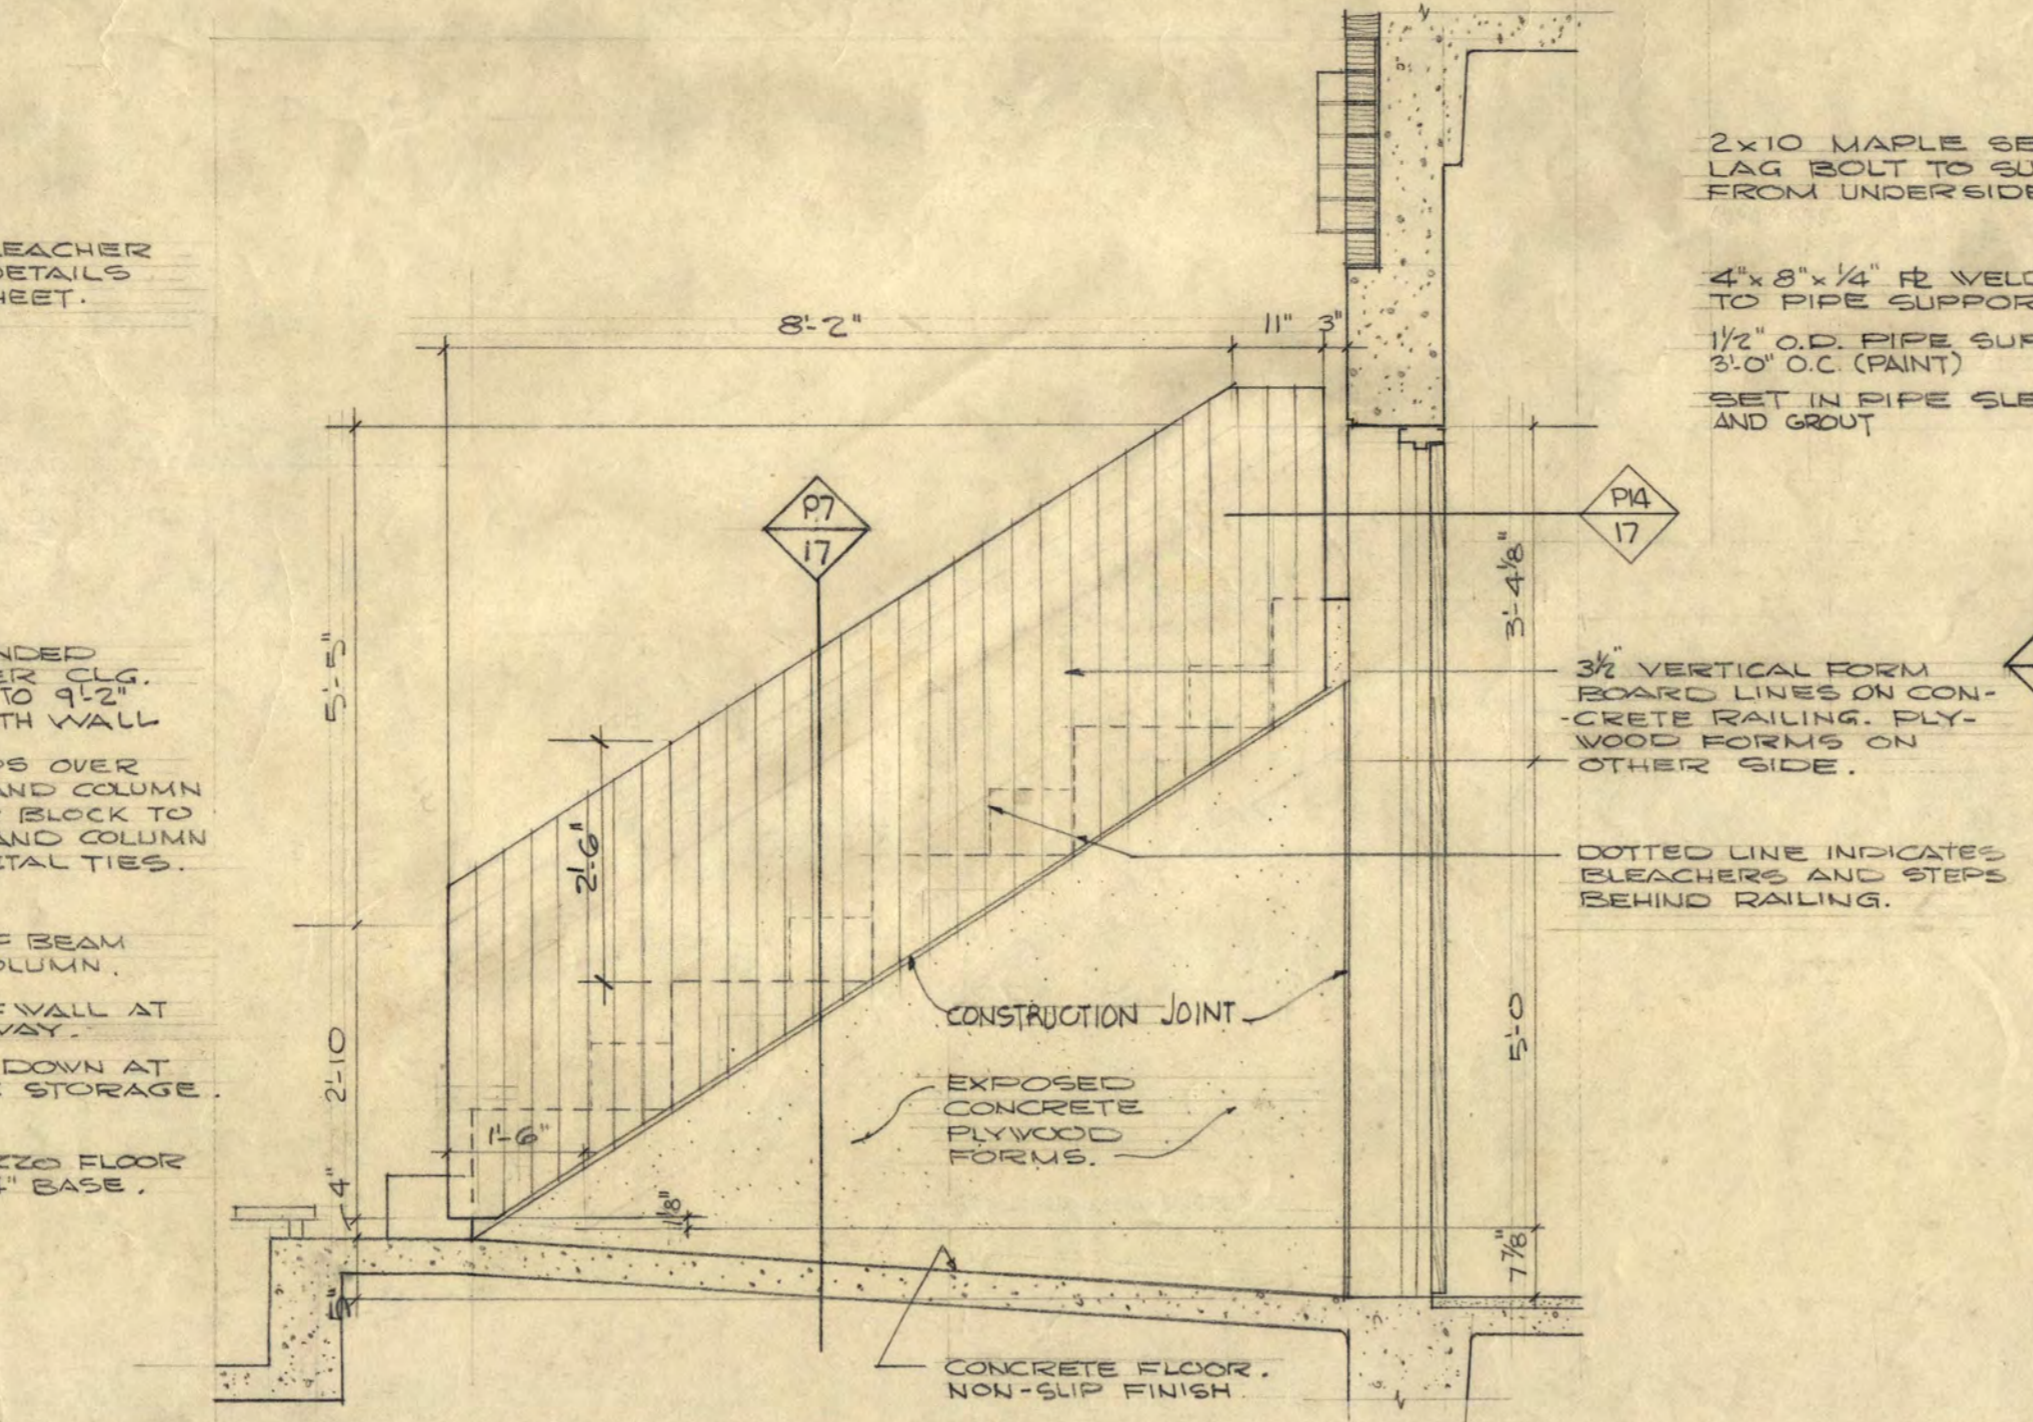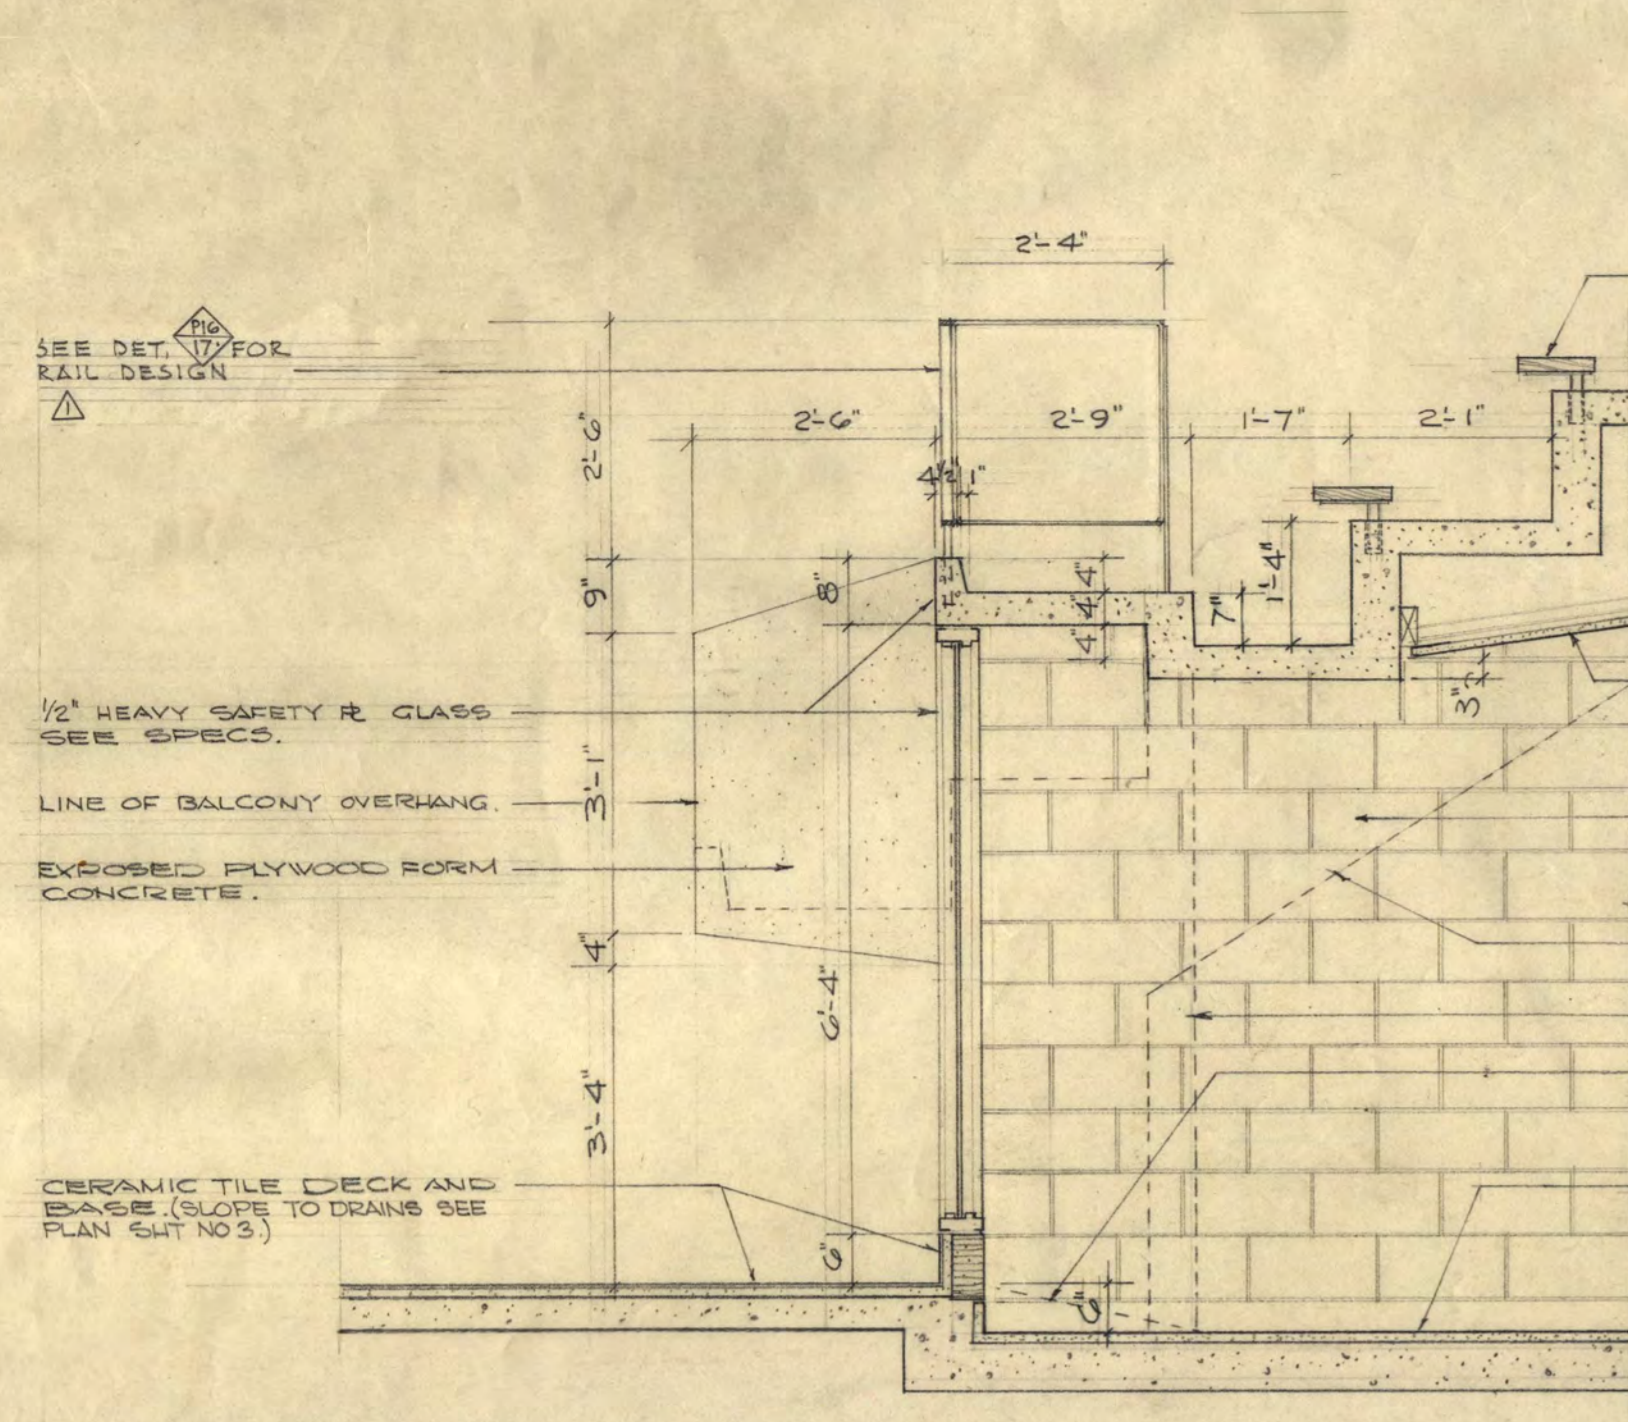

**18**

**INSTRUCTIONAL BUILDING FOR PHYSICAL EDUCATION**  
ST. CLOUD STATE COLLEGE  
ST. CLOUD, MINNESOTA

DEPARTMENT OF ADMINISTRATION  
ROOM 110 STATE CAPITOL BUILDING  
ARCHITECTURAL AND ENGINEERING DIVISION  
ST. PAUL, MINN. 55155

APPROVED BY: PRESIDENT BY ST. CLOUD STATE COLLEGE  
APPROVED BY: STATE COLLEGE BOARD  
APPROVED BY: COMMISSIONER OF ADMINISTRATION OR AN AUTHORIZED SIGNATURE

A. J. NELSON, STATE ARCHITECT


**17**

**WALL SECTIONS POOL**

TRAYNOR AND HERMANSON ARCHITECTS ST. CLOUD

DATE 1-17-63  
DRAWN TWS, TJC  
CHECKED AS BUILT

PROJECT NUMBER 3425

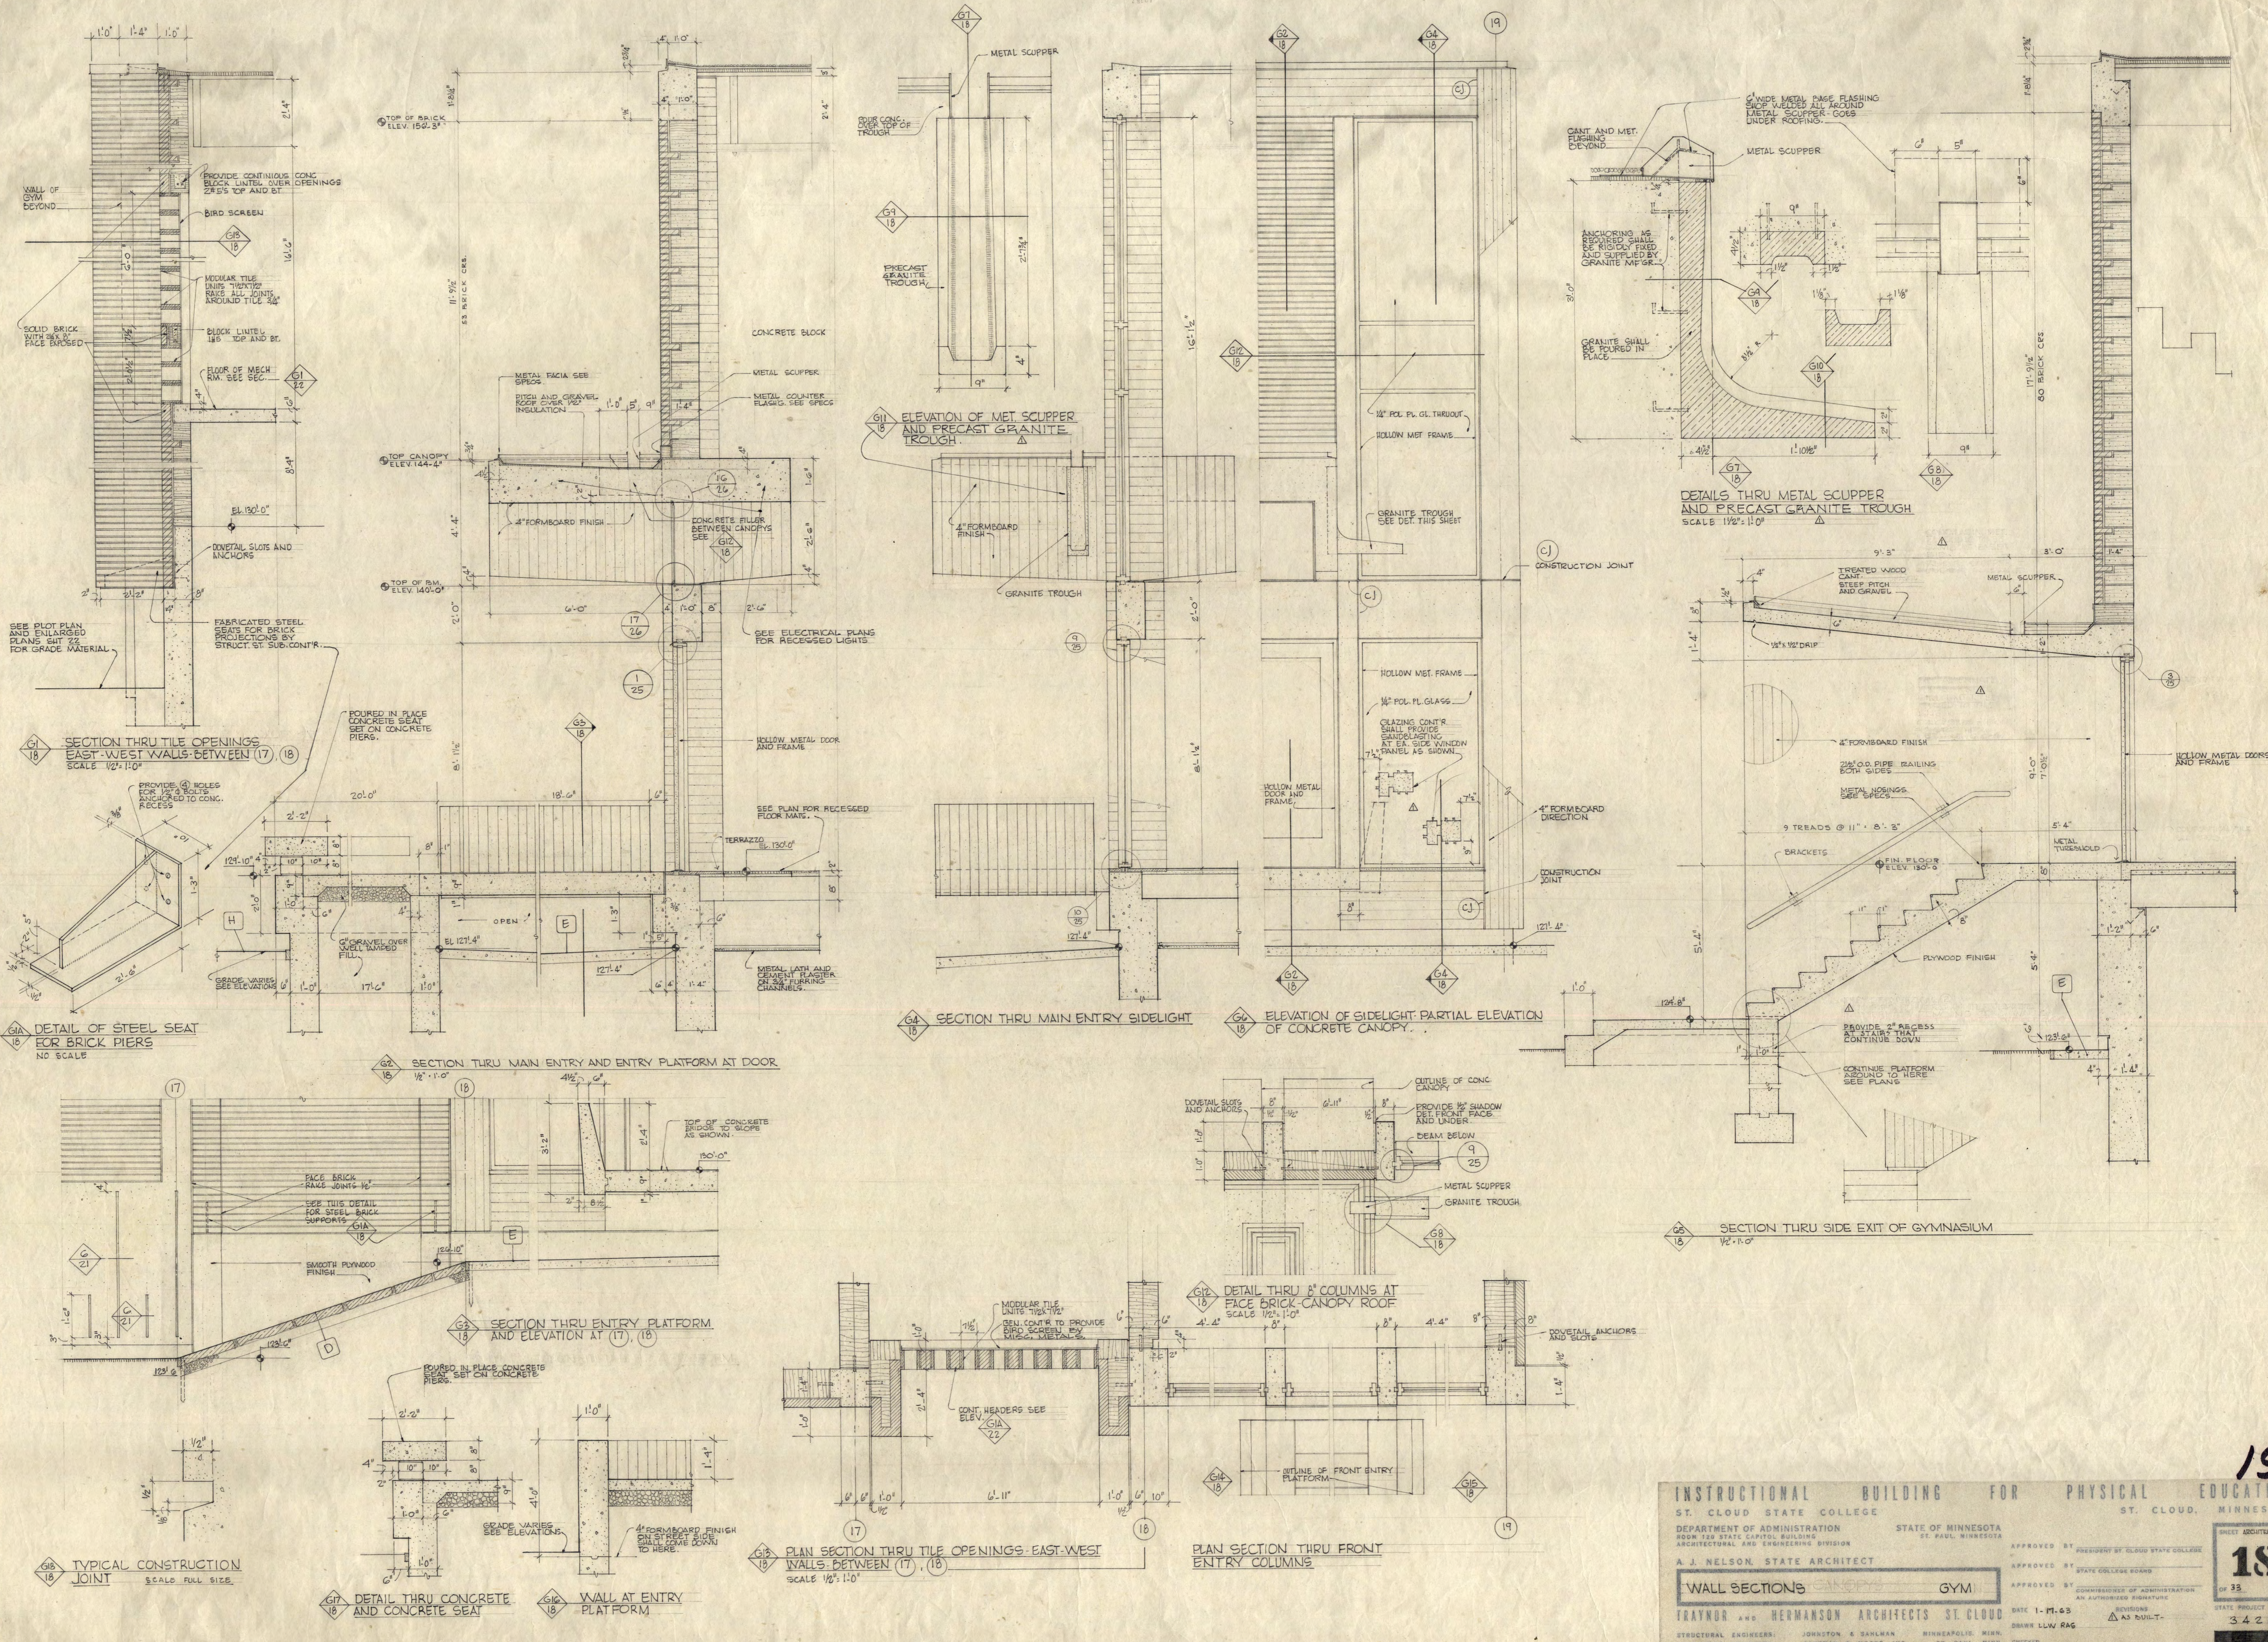

SECTION THRU TILE OPENINGS EAST-WEST WALLS BETWEEN (17) (18) SCALE 1/2" = 1'-0"

DETAIL OF STEEL SEAT FOR BRICK PIERS NO SCALE

SECTION THRU MAIN ENTRY AND ENTRY PLATFORM AT DOOR 1/2" = 1'-0"

TYPICAL CONSTRUCTION JOINT SCALE FULL SIZE

DETAIL THRU CONCRETE AND CONCRETE SEAT WALL AT ENTRY PLATFORM

SECTION THRU MAIN ENTRY SIDELIGHT SCALE 1/2" = 1'-0"

ELEVATION OF SIDELIGHT-PARTIAL ELEVATION OF CONCRETE CANOPY

PLAN SECTION THRU TILE OPENINGS-EAST-WEST WALLS BETWEEN (17) (18) SCALE 1/2" = 1'-0"

PLAN SECTION THRU FRONT ENTRY COLUMNS

DETAILS THRU METAL SCUPPER AND PRECAST GRANITE TROUGH SCALE 1/2" = 1'-0"

SECTION THRU SIDE EXIT OF GYMNASIUM 1/2" = 1'-0"

19

**INSTRUCTIONAL BUILDING FOR PHYSICAL EDUCATION**

ST. CLOUD STATE COLLEGE ST. CLOUD, MINNESOTA

DEPARTMENT OF ADMINISTRATION STATE OF MINNESOTA  
 ROOM 120 STATE CAPITOL BUILDING ST. PAUL, MINNESOTA

APPROVED BY: PRESIDENT BY CLOUD STATE COLLEGE  
 APPROVED BY: STATE COLLEGE BOARD  
 APPROVED BY: COMMISSIONER OF ADMINISTRATION AN APPROVED SIGNATURE

**A. J. NELSON, STATE ARCHITECT**

**WALL SECTIONS CANOPY GYM**


TRAYNOR AND HERMANSON ARCHITECTS ST. CLOUD

STRUCTURAL ENGINEERS: JOHNSTON & SANLHAN MINNEAPOLIS, MINN.  
 CONSULTING ENGINEERS: SAUGHAN & MOORE, INC. ST. PAUL, MINN.

DATE: 1-11-63  
 DRAWN: LLW:RAG  
 CHECKED: [Signature]

18

OF 33  
 STATE PROJECT NUMBER  
 3425

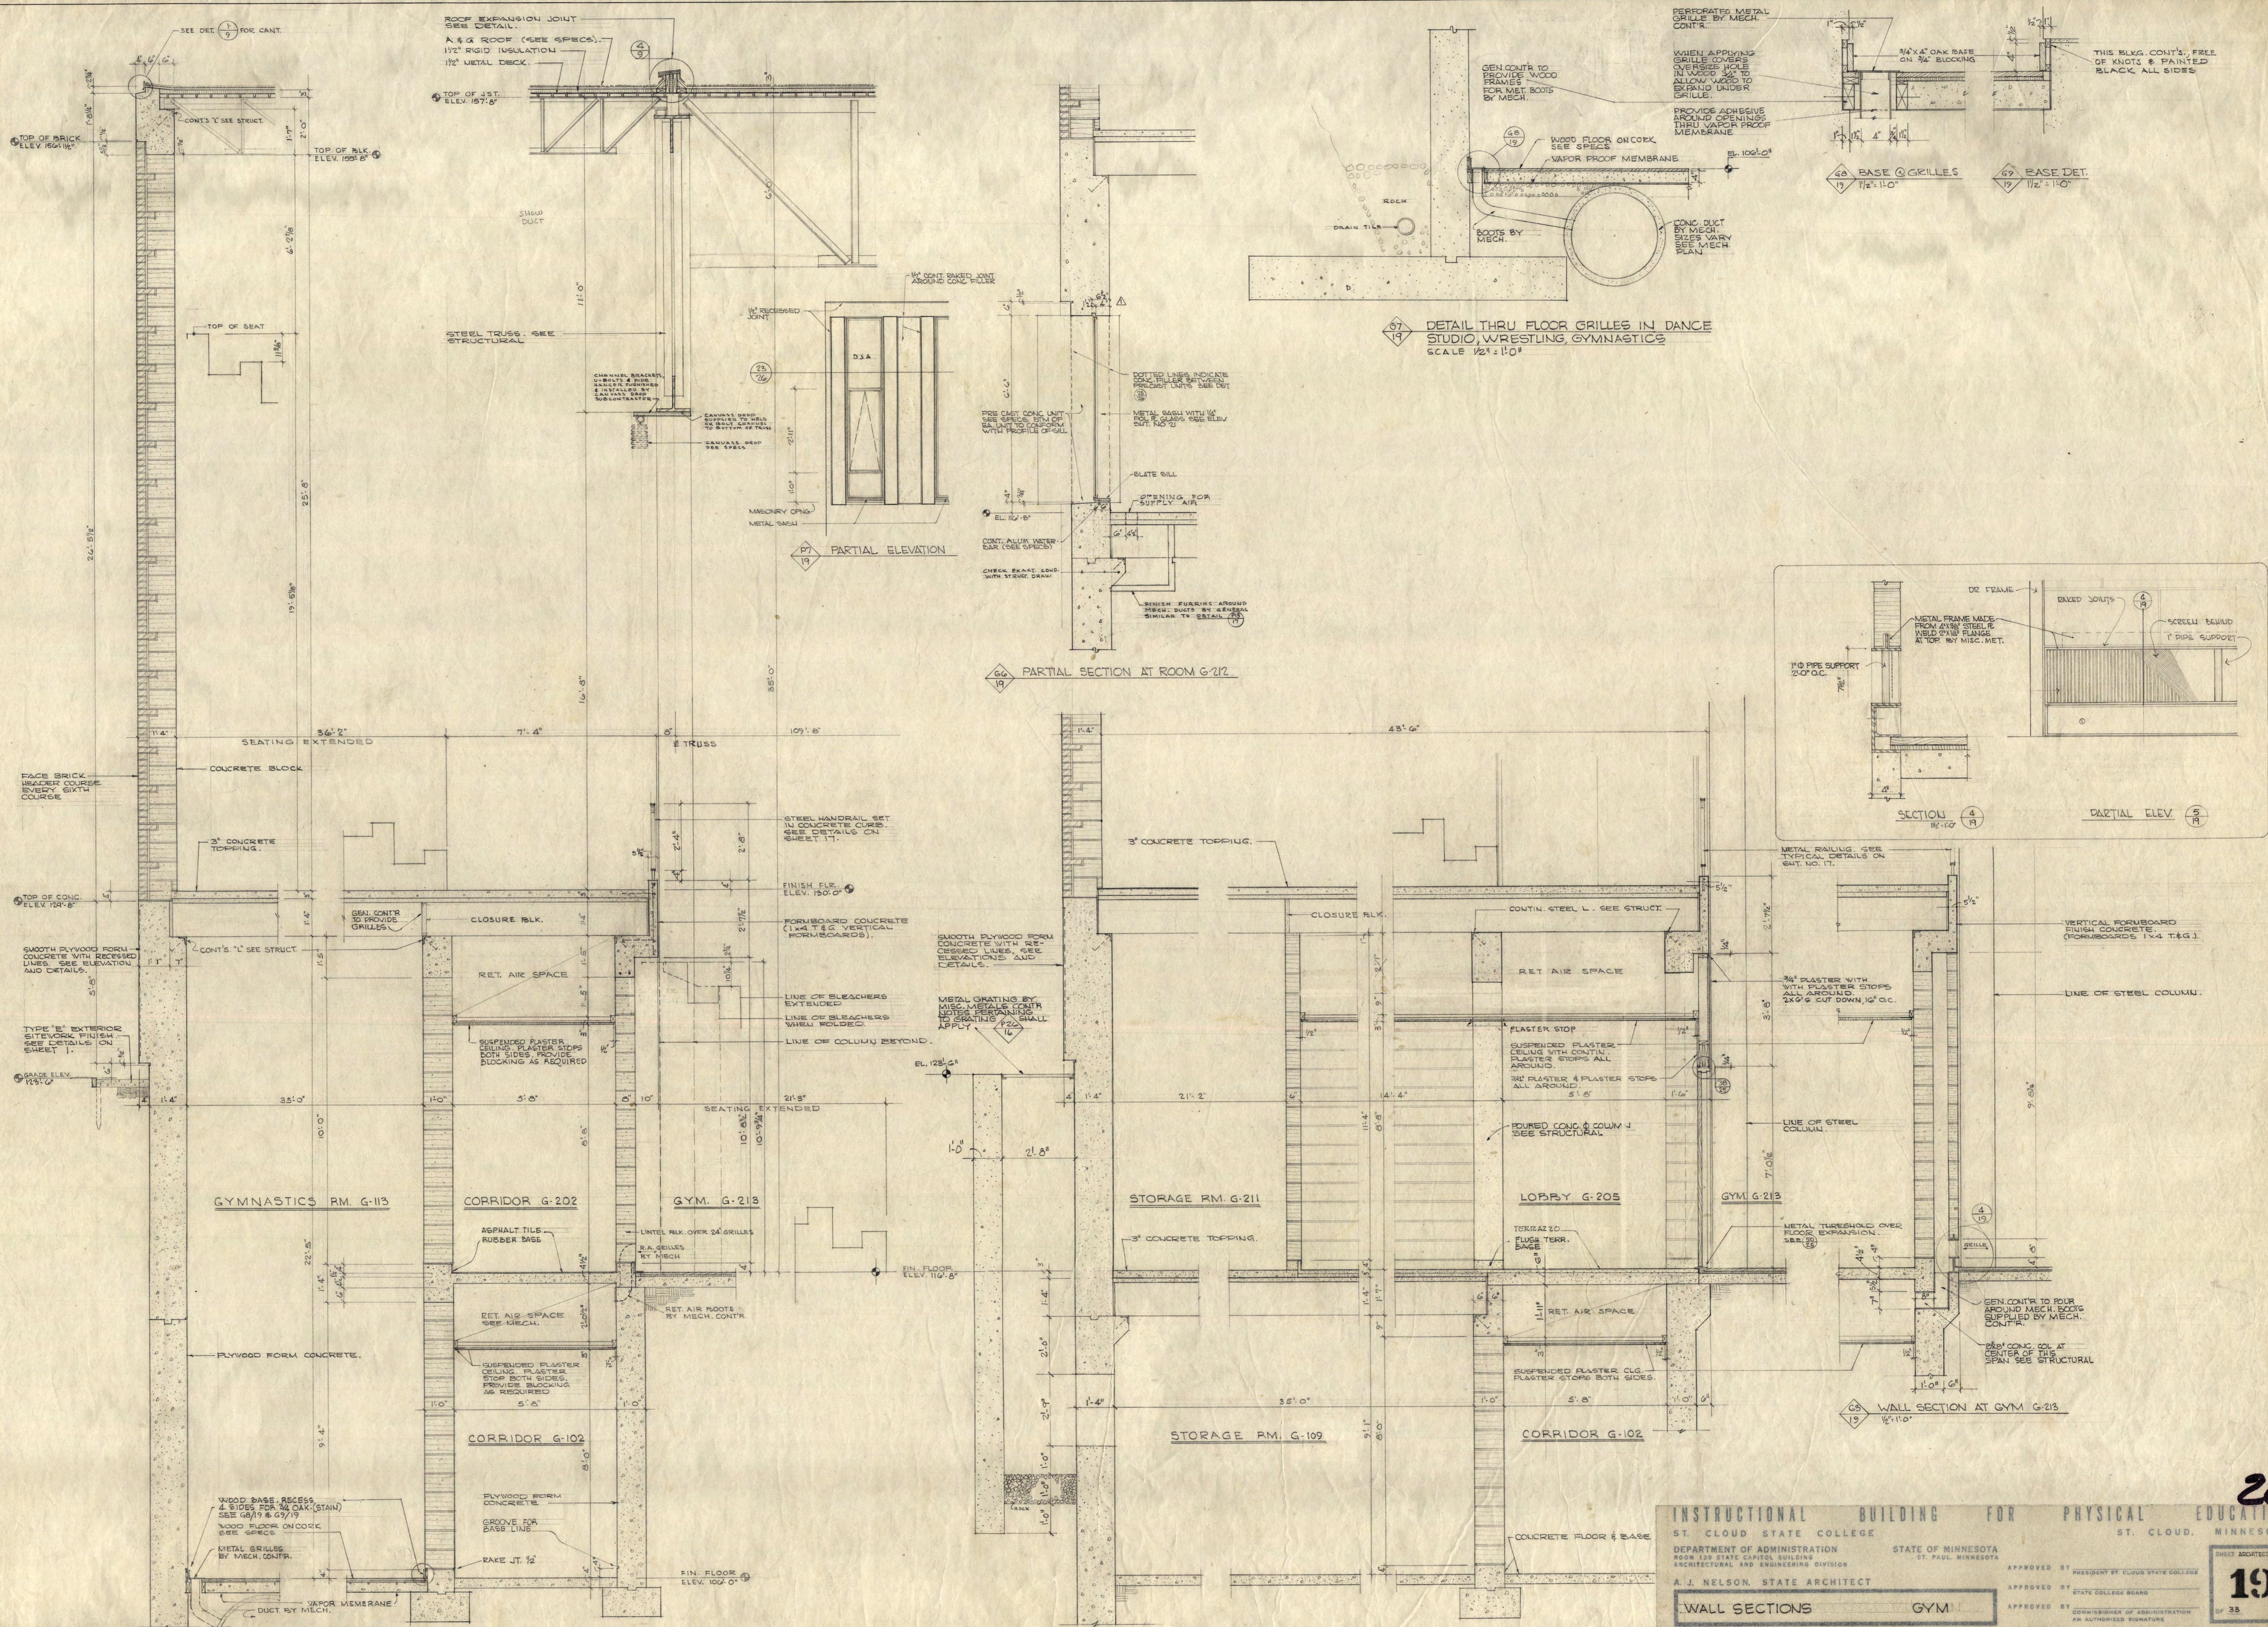

61 SECTION THRU EAST WALL OF GYMNASIUM - WEST WALL SIMILAR  
1/2" = 1'-0"

62 PARTIAL SECTION THRU EAST WALL OF GYMNASIUM  
1/2" = 1'-0"

67 DETAIL THRU FLOOR GRILLES IN DANCE STUDIO, WRESTLING GYMNASIUM  
SCALE 1/2" = 1'-0"

66 PARTIAL SECTION AT ROOM G-212  
1/2" = 1'-0"

SECTION 4  
1/2" = 1'-0"

63 WALL SECTION AT GYM G-213  
1/2" = 1'-0"

20

**INSTRUCTIONAL BUILDING FOR PHYSICAL EDUCATION**

ST. CLOUD STATE COLLEGE      ST. CLOUD, MINNESOTA

DEPARTMENT OF ADMINISTRATION      STATE OF MINNESOTA  
ROOM 120 STATE CAPITOL BUILDING      ST. PAUL, MINNESOTA

**A. J. NELSON, STATE ARCHITECT**

**WALL SECTIONS      GYM**

**TRAYNOR AND HERMANSON ARCHITECTS ST. CLOUD**

STRUCTURAL ENGINEERS: JOHNSTON & SARLWAL      MINNEAPOLIS, MINN.  
CONSULTING ENGINEERS: GAUGHAN & MOORE, INC.      ST. PAUL, MINN. CHECKED

APPROVED BY: PRESIDENT ST. CLOUD STATE COLLEGE  
APPROVED BY: STATE COLLEGE BOARD  
APPROVED BY: COMMISSIONER OF ADMINISTRATION  
DATE: 1-17-53      DRAWN: L.V.V., T.V.S., J.O. RAB

19

STATE PROJECT NUMBER: 3425